


TOWNSHIP 3 SOUTH, RANGE 5 EAST, W. M.
SECTION 30

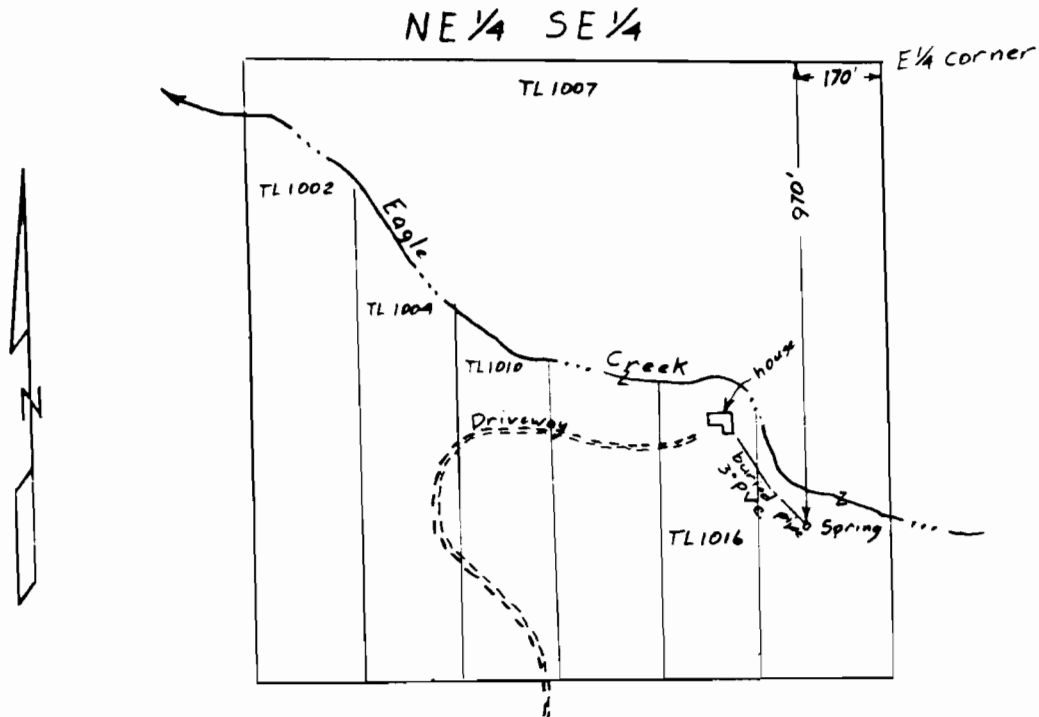

Scale 1" = 400'

Surveyed June 21, 1999

RECEIVED


JUL 23 1999

WATER RESOURCES DEPT
SALEM OREGON

Claim of Beneficial Use Map
for

THOMAS & PENNY FANNING

App. 72455
Per. 51691

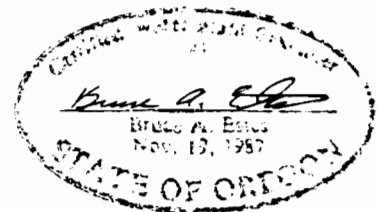

Expires Dec. 31, 1999

This map is for the purpose of
locating a water right only
and has no intent to provide
legal dimensions or the location
of property lines.

ESTES SURVEYS

6293 Sunnyview Rd. NE 80382 Arnold Rd.
Salem, OR 97305 Bend, OR 97702
(503) 585-7593 (503) 382-7391