

T. 3 S., R. 3 S., W.M.

I certify that the information I have provided in this Final Proof is an accurate representation of the permitted water use and is true and correct to the best of my knowledge. This map is to be used for the purpose of identifying the location of water right only and is not intended to provide legal dimensions or locations of property ownership lines.

Matt Dunckel, CWRE

Place of Domestic Use Expanded.

existing reservoir

1" Supply Line
Length = 1500'±

15

14

443'

off channel

191'

run

22

23

163'

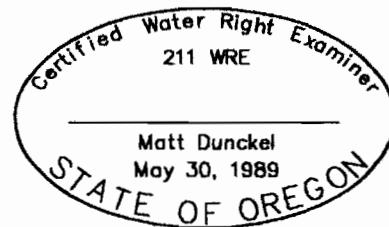
SUNNYCREST ROAD

Scale: 1" = 400'

LEGEND:

- _____ = Property line
 _____ = Section line
 _____ = "40" line

North

**RECEIVED**

DEC 29 2003

WATER RESOURCES DEPT
SALEM, OREGONFINAL PROOF SURVEY
UNDER

Application No. R-72447 Permit No. S-51668

IN NAME OF

RODNEY & STARR MANSON

Surveyed 1 DEC., 2003,

#1413