


T. 13 S., R. 7 W., W.M.

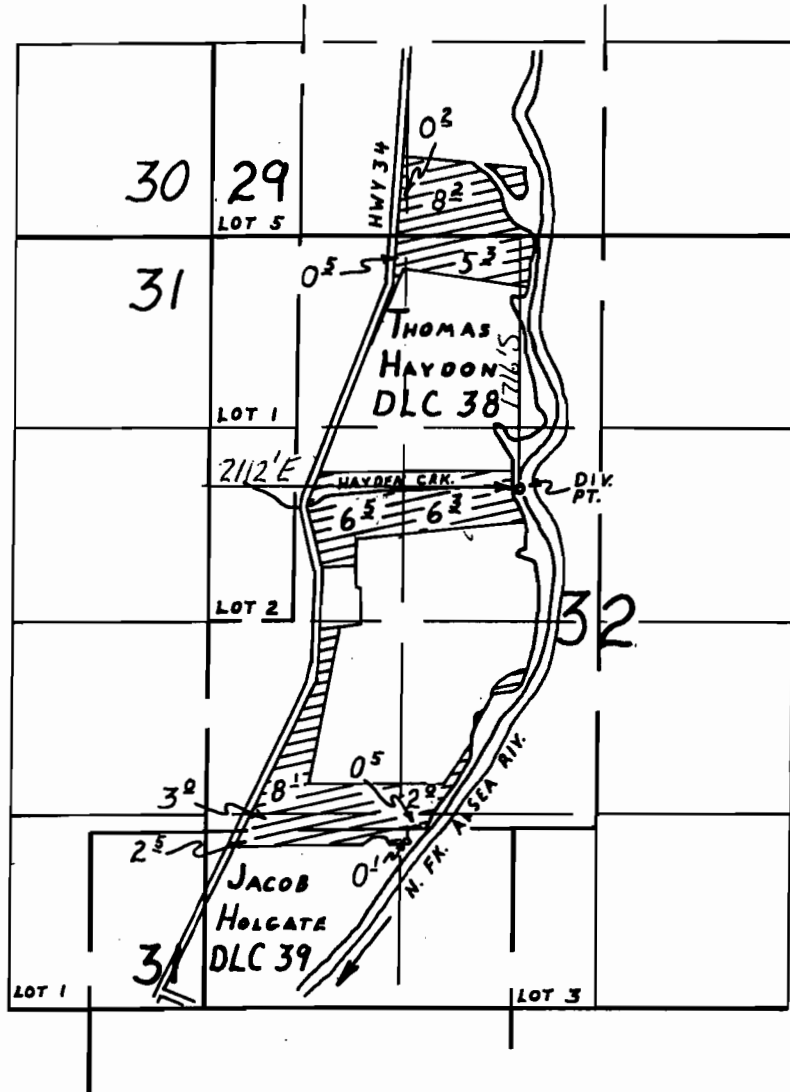

FINAL PROOF SURVEY

UNDER

Application No. 57370 Permit No. 43199
IN NAME OF

FLOYD M. STOUT

Surveyed AUGUST 20, 1992, by R.W. KLASSEN