

29

20 21
29 28

RECEIVED

SEP 28 1998

WATER RESOURCE DEPT
SALEM OREGON

NW 1/4 SE 1/4

NE 1/4 SE 1/4

POINT OF DIVERSION
IS SOUTH 1735' AND
WEST 976' FROM THE
EAST 1/4 CORNER OF
SEC. 29.

SW 1/4 SE 1/4

GRAVEL DRIVE

HOUSE

SHED

HWY 36

LAKE CREEK

SE 1/4 SE 1/4

THIS MAP IS FOR THE PURPOSE
OF IDENTIFYING THE LOCATION
OF THE WATER RIGHT ONLY.
THERE IS NO INTENT TO PROVIDE
DIMENSIONS OR LOCATION OF
PROPERTY OWNERSHIP LINES.

NOTE: AREA IRRIGATED IS 0.06 ACRES.



INDICATES AREA TO BE IRRIGATED.

29 28
32 33



FINAL PROOF WATER RIGHTS MAP

UNDER
PERMIT 51823
APPLICATION NO. 72117

17-09-29-4, T.L. 2600
SE 1/4, SE 1/4, SEC 29, T17S, R9W, W.M.
LANE COUNTY, OREGON

FOR: CALVIN W. HURD
13482 HIGHWAY 36
SWISSHOME, OREGON 97480

PREPARED BY: WOBBE & ASSOCIATES, INC.
510 KINGWOOD ST. / P.O. BOX 3093
FLORENCE, OR 97439
DATE: JULY 31, 1998

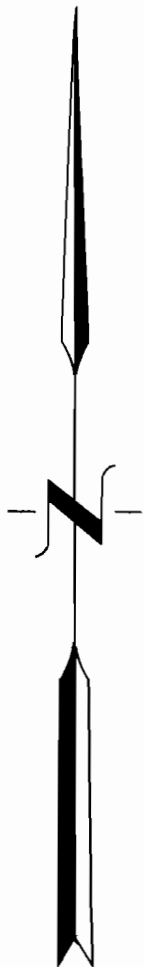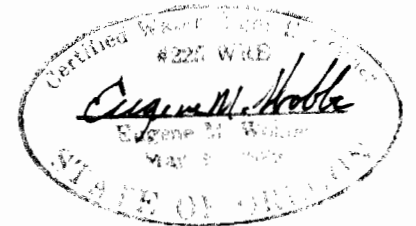

SCALE
1" = 400'