


Tax Lot 400 Tax Account No. 171.01
Section 10 Township 23S Range 12W W.M.
Coos County

RECEIVED

DEC - 9 1996

WATER RESOURCES DEPT.
SALEM, OREGON

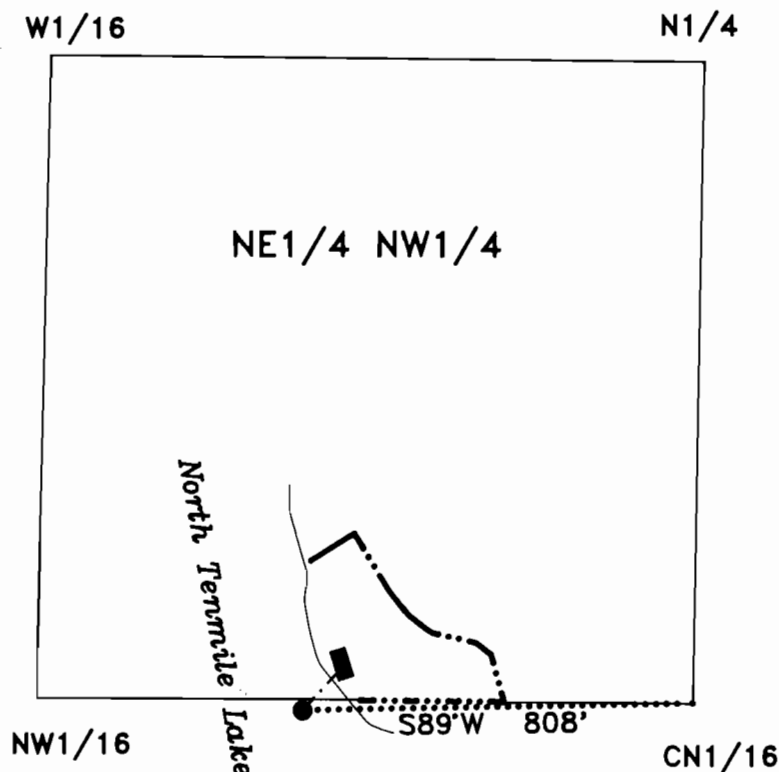

Legend

- P.O.D.
- Property Line
- Waterline
- House

EXAMINERS DISCLAIMER STATEMENT

The preparation of this map was for the purpose of identifying the location of the Water Right only and has no intent to provide dimensions or location of property ownership lines.

FINAL PROOF SURVEY
IN THE NAME OF
Arthur J. Schroeder



Surveyed on 11/7/96 by H.A. Wilcox

Application No. S-80930
Permit No. 52962