


RECEIVED

SEP 30 1999

T4N, R7W, W.M.
SECTION 7
IN THE SE 1/4 NE 1/4

WATER RESOURCES DEPT.
SALEM, OREGON

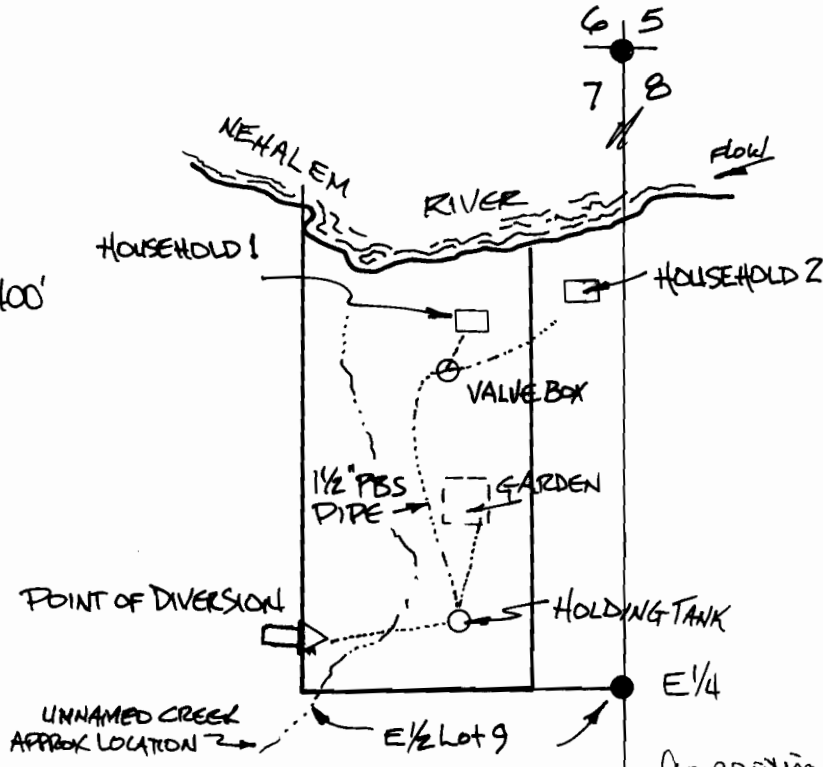


Approximate POD:
110' N & 675' WEST
FROM E 1/4 CORNER,
Sec 7

FINAL PROOF SURVEY
under
APPLICATION # S-71781
PERMIT # 51894

for:
MARJORIE A. LAKE
41544 NEHALEM SHORES LN.
SEASIDE, OREGON
97138

by: LESLIE G. KEENON
1224 ALDER ST.
VERNONIA, OREGON
97064
SEPT. 20, 1999

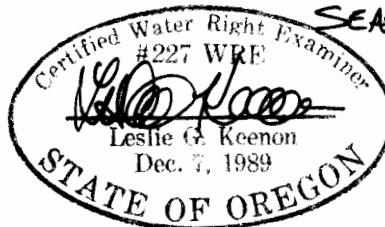

Amended by WRD Staff, 7-7-06, JWS