

Section 28 Township 29S Range 11W W.M.
Coos County

RECEIVED

MAR 28 1997

WATER RESOURCES DEPT.
SALEM, OREGON

Legend


P.O.B.

P.O.D.

PROPERTY


LINE

PIPE

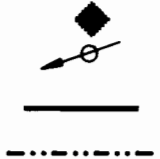

NOTE:

The P.O.D. is an in-spring screened device attached to the end of the pipe. The P.O.D. is located 830 feet east and 1046 feet South of the Northwest corner of Section 28.

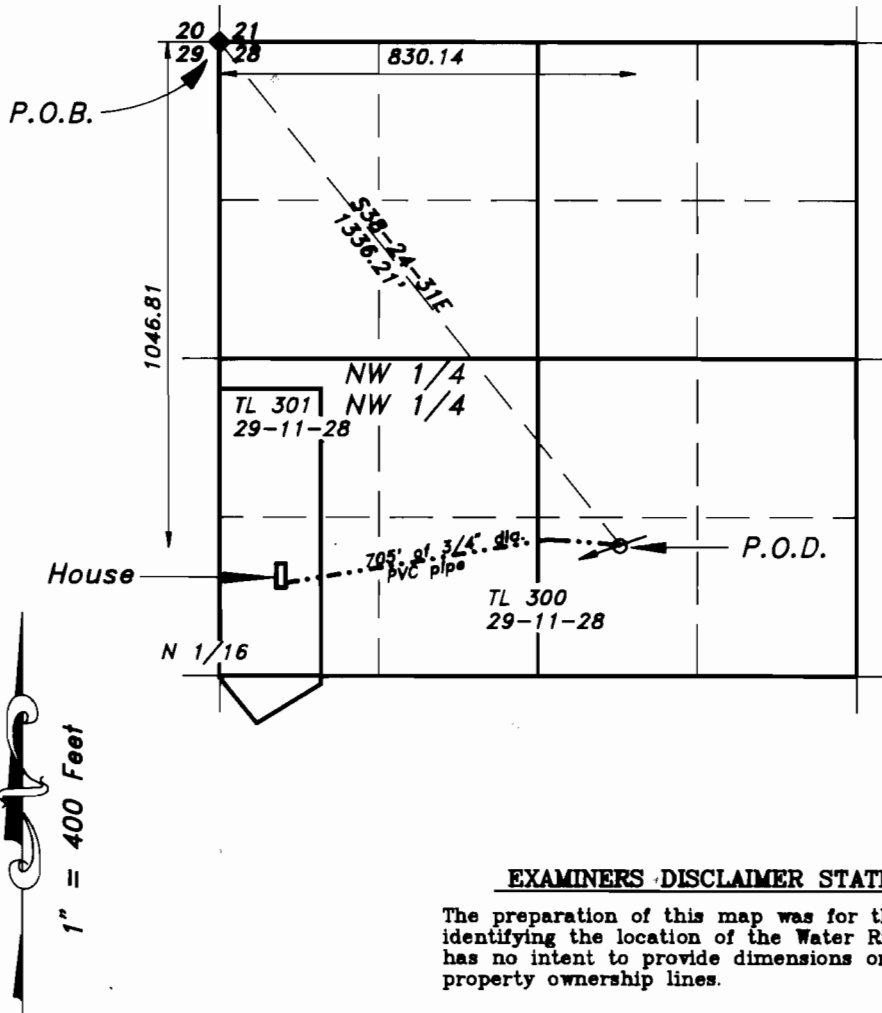

EXAMINERS DISCLAIMER STATEMENT

The preparation of this map was for the purpose of identifying the location of the Water Right only and has no intent to provide dimensions or location of property ownership lines.

FINAL PROOF SURVEY

Prepared For: Myra M. Parrish
Prepared By: Dennis Goude
Surveyed: November 11, 1996



EXPIRES 06/30/98

Stuntzner Engineering

& Forestry, LLC

ENGINEERING * LAND SURVEYING * FORESTRY
PLANNING * WATER RIGHTS

705 South 4th St.
Post Office Box 118
Coos Bay, Oregon 97426

Phone (541) 267-2872
Fax (541) 267-0588

Application No. S-71769

Permit No. 52297