

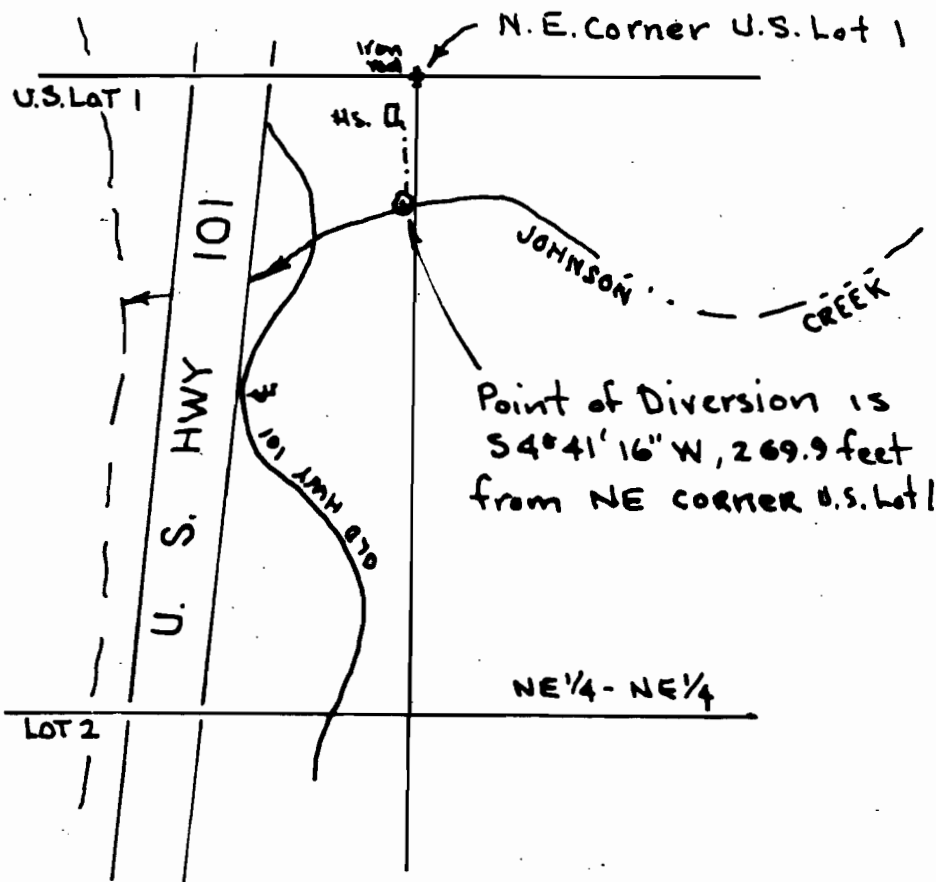


PACIFIC OCEAN

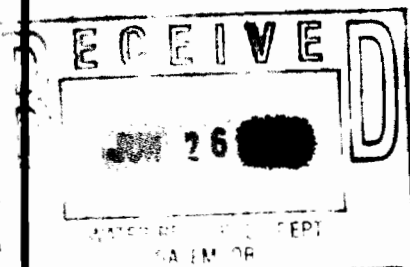

Scale: $1'' = 400'$

CLAIM OF BENEFICIAL USE
FINAL PROOF SURVEY
UNDER

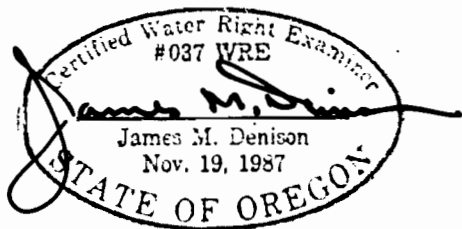

Application No. 72999 Permit No. 52078
 IN NAME OF


THIS MAP PREPARED SOLELY FOR THE PURPOSE OF SHOWING LOCATION OF A WATER RIGHT, AND IS NOT INTENDED FOR USE TO PROVIDE DIMENSIONS OR LOCATION OF PROPERTY OWNERSHIP LINES.