


Tax Lot No. TL500 26 12 18B  
 Section 18 Township 26S Range 12W W.M.  
 Coos County

**RECEIVED**  
 MAR 19 1999  
 WATER RESOURCES DEPT.  
 SALEM, OREGON

Scale 1" = 400'

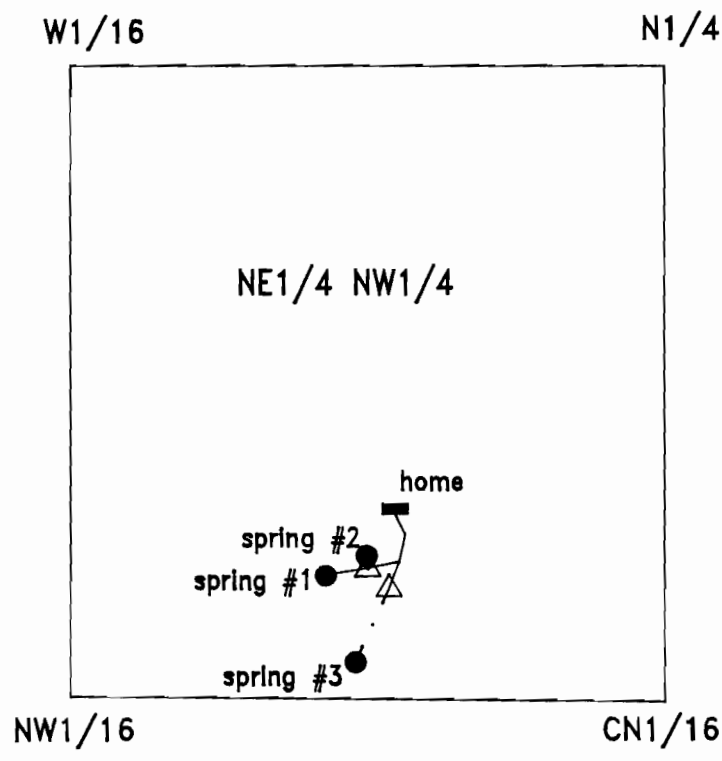

**LEGEND**

- HOME
- POINT OF DIVERSION
- △ STORAGE TANK
- · - WATERLINE
- · · - PROPERTY LINE

- spring #1- bears N64°23'E 582' from the NW1/16
- spring #2- bears N64°19'E 677' from the NW1/16
- spring #3- bears N83° 00'E 591' from the NW1/16

**EXAMINERS DISCLAIMER STATEMENT**

The preparation of this map was for the purpose of identifying the location of the Water Right only and has no intent to provide dimensions or location of property ownership lines.

**FINAL PROOF SURVEY**  
 IN THE NAME OF  
Dennis & Kathryn Netter

Certified Water Right Examiner  
 #142  
*Harvey Wilcox*  
 Harvey Wilcox  
 Nov. 19, 1987  
 STATE OF OREGON  
 RENEWAL 6/30/00

Surveyed on 2/10/99 by H.A. Wilcox

Application No. S-81171  
 Permit No. 53222