


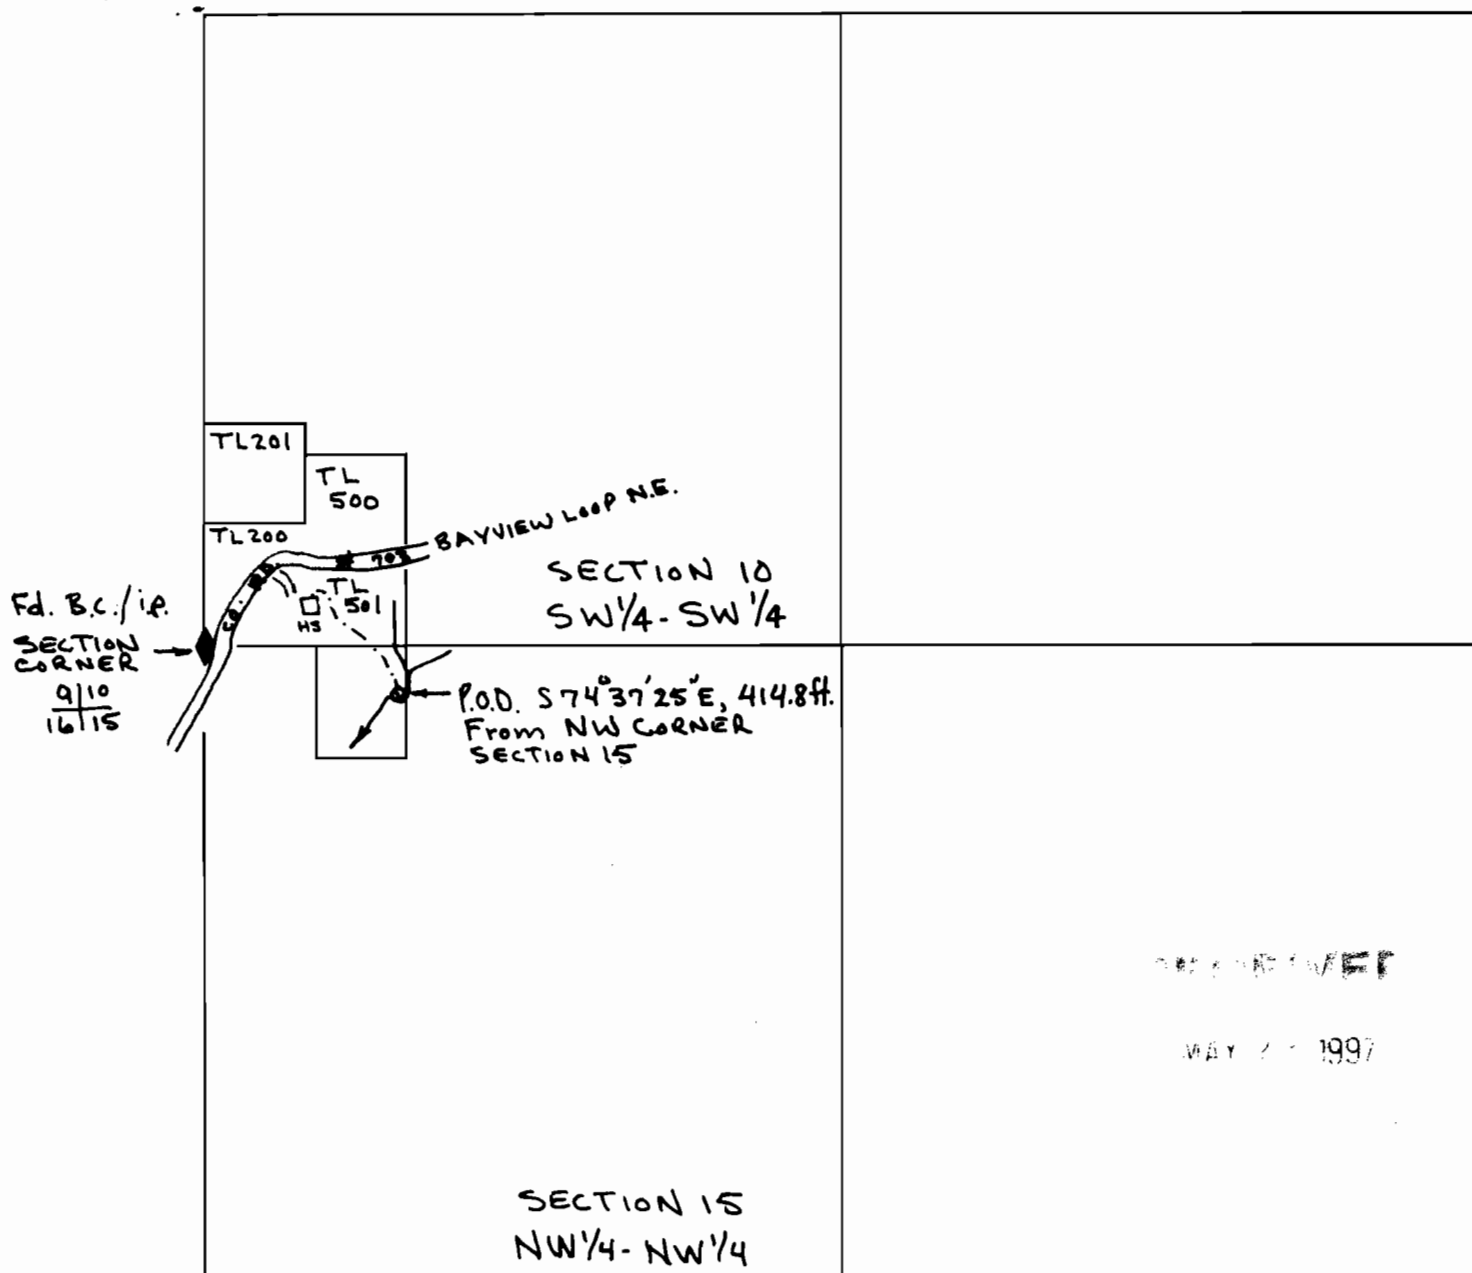

T13S, R11W, W.M.
SW 1/4 - SW 1/4 SECTION 10
NW 1/4 - NW 1/4 SECTION 15
LINCOLN COUNTY, OREGON

SCALE 1 inch = 400 feet



FINAL PROOF SURVEY UNDER
APPLICATION • S-72932 **PERMIT • 52211**
IN THE NAME OF
THERESA MCCrackEN

SURVEYED: MARCH 12, 1997

BY: J. M. DENISON

THIS MAP PREPARED SOLEY FOR THE PURPOSE OF SHOWING LOCATION OF A WATER RIGHT, AND IS NOT INTENDED FOR USE TO PROVIDE DIMENSIONS OR LOCATION OF PROPERTY OWNERSHIP LINES

James M. Denison