


CLAIM OF BENEFICIAL USE FINAL PROOF MAP


Located in the SW¼ NW¼ & SW¼ NE¼ of
Section 22, Township 31 South, Range 15 West, W.M.
Curry County, Oregon
Application # S-72618 Permit #53530

NOTE:
The P.O.D. is a block catch basin 10' x 4' x 1'
with a screened 1½" Ø PVC pipe connecting to
the place of use. The P.O.D. is located 3000
feet East and 1750 feet South of the North-
west corner of Section 22.

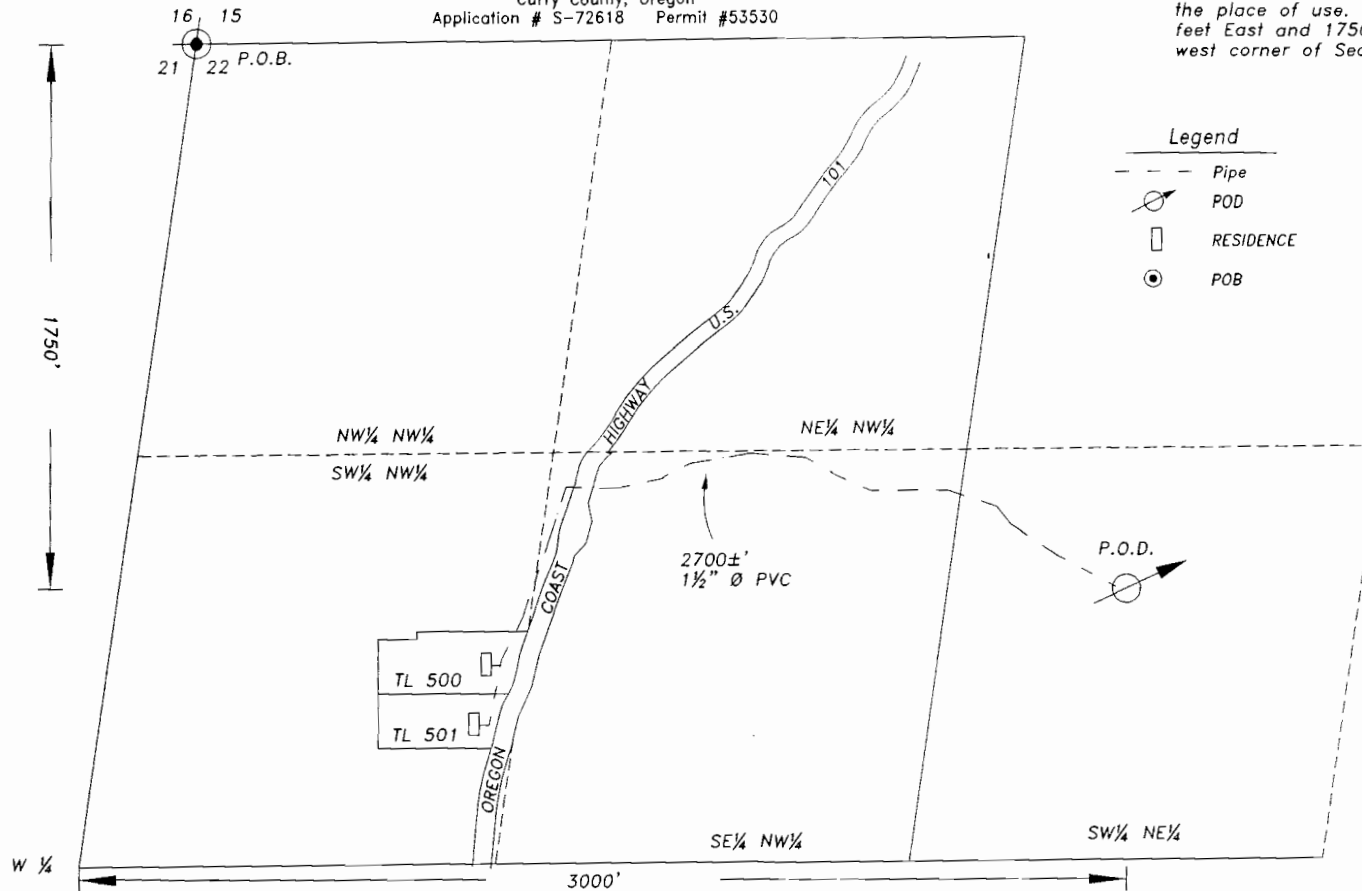

- Legend
- Pipe
 - ⊗ P.O.D.
 - RESIDENCE
 - ⊙ P.O.B.

Prepared For: Allen D. Todd &
Betty Rogers
Prepared By: Dennis Goude
Surveyed: June 23, 1999

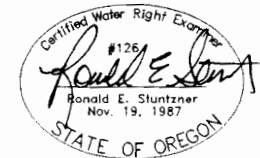

EXPIRES 06/30/2000

RECEIVED

NOV 12 1999

WATER RESOURCES DEPT.
SALEM, OREGON

EXAMINERS DISCLAIMER STATEMENT

The preparation of this map was for the purpose of
identifying the location of the Water Right only and
has no intent to provide dimensions or location of
property ownership lines.

**Stuntzner Engineering
& Forestry, LLC**

ENGINEERING * LAND SURVEYING * FORESTRY
PLANNING * WATER RIGHTS

705 South 4th St.
Post Office Box 118
Coos Bay, Oregon 97420
Phone (541) 267-2872
Fax (541) 267-0588

99-192