

FINAL PROOF SURVEY for

JACK & FREEDA KEMNITZER

in the NW 1/4, SW 1/4, Section 34

T 39 S, R 14 W, W.M.

Curry County, Oregon

Application No. 71875

Permit No. 51640


scale: 1" = 660'

December, 1995

RECEIVED

JAN 12 1996

WATER RESOURCES DEPT
SALEM, OREGON

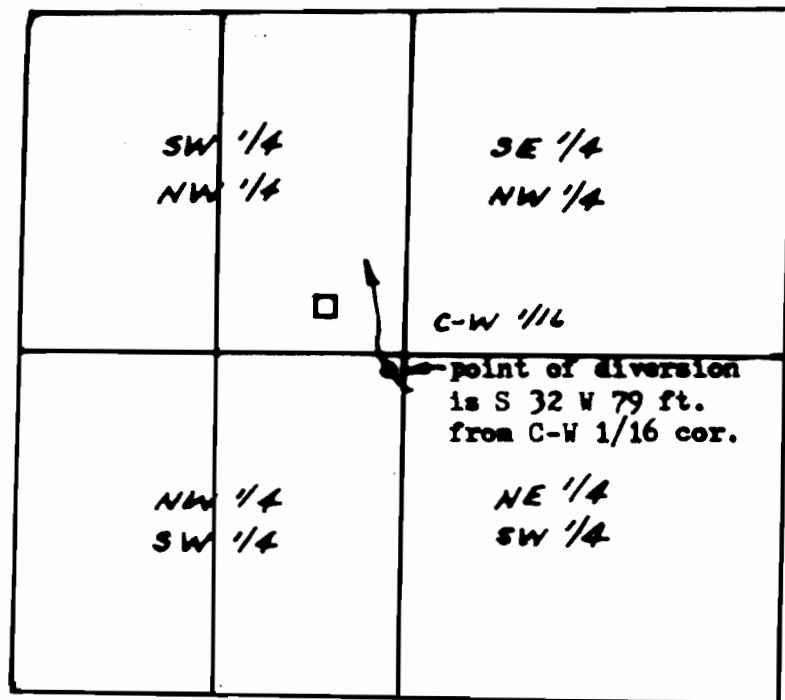

Center 1/4
Sec. 34

The purpose of this map is to identify the location of a water right. It is not intended to give information relative to the location of property ownership lines.

Donald Cormack, CWRE
P.O. Box 1280
Brookings, Oregon

