
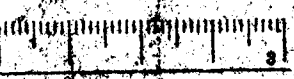


8027

45 12E

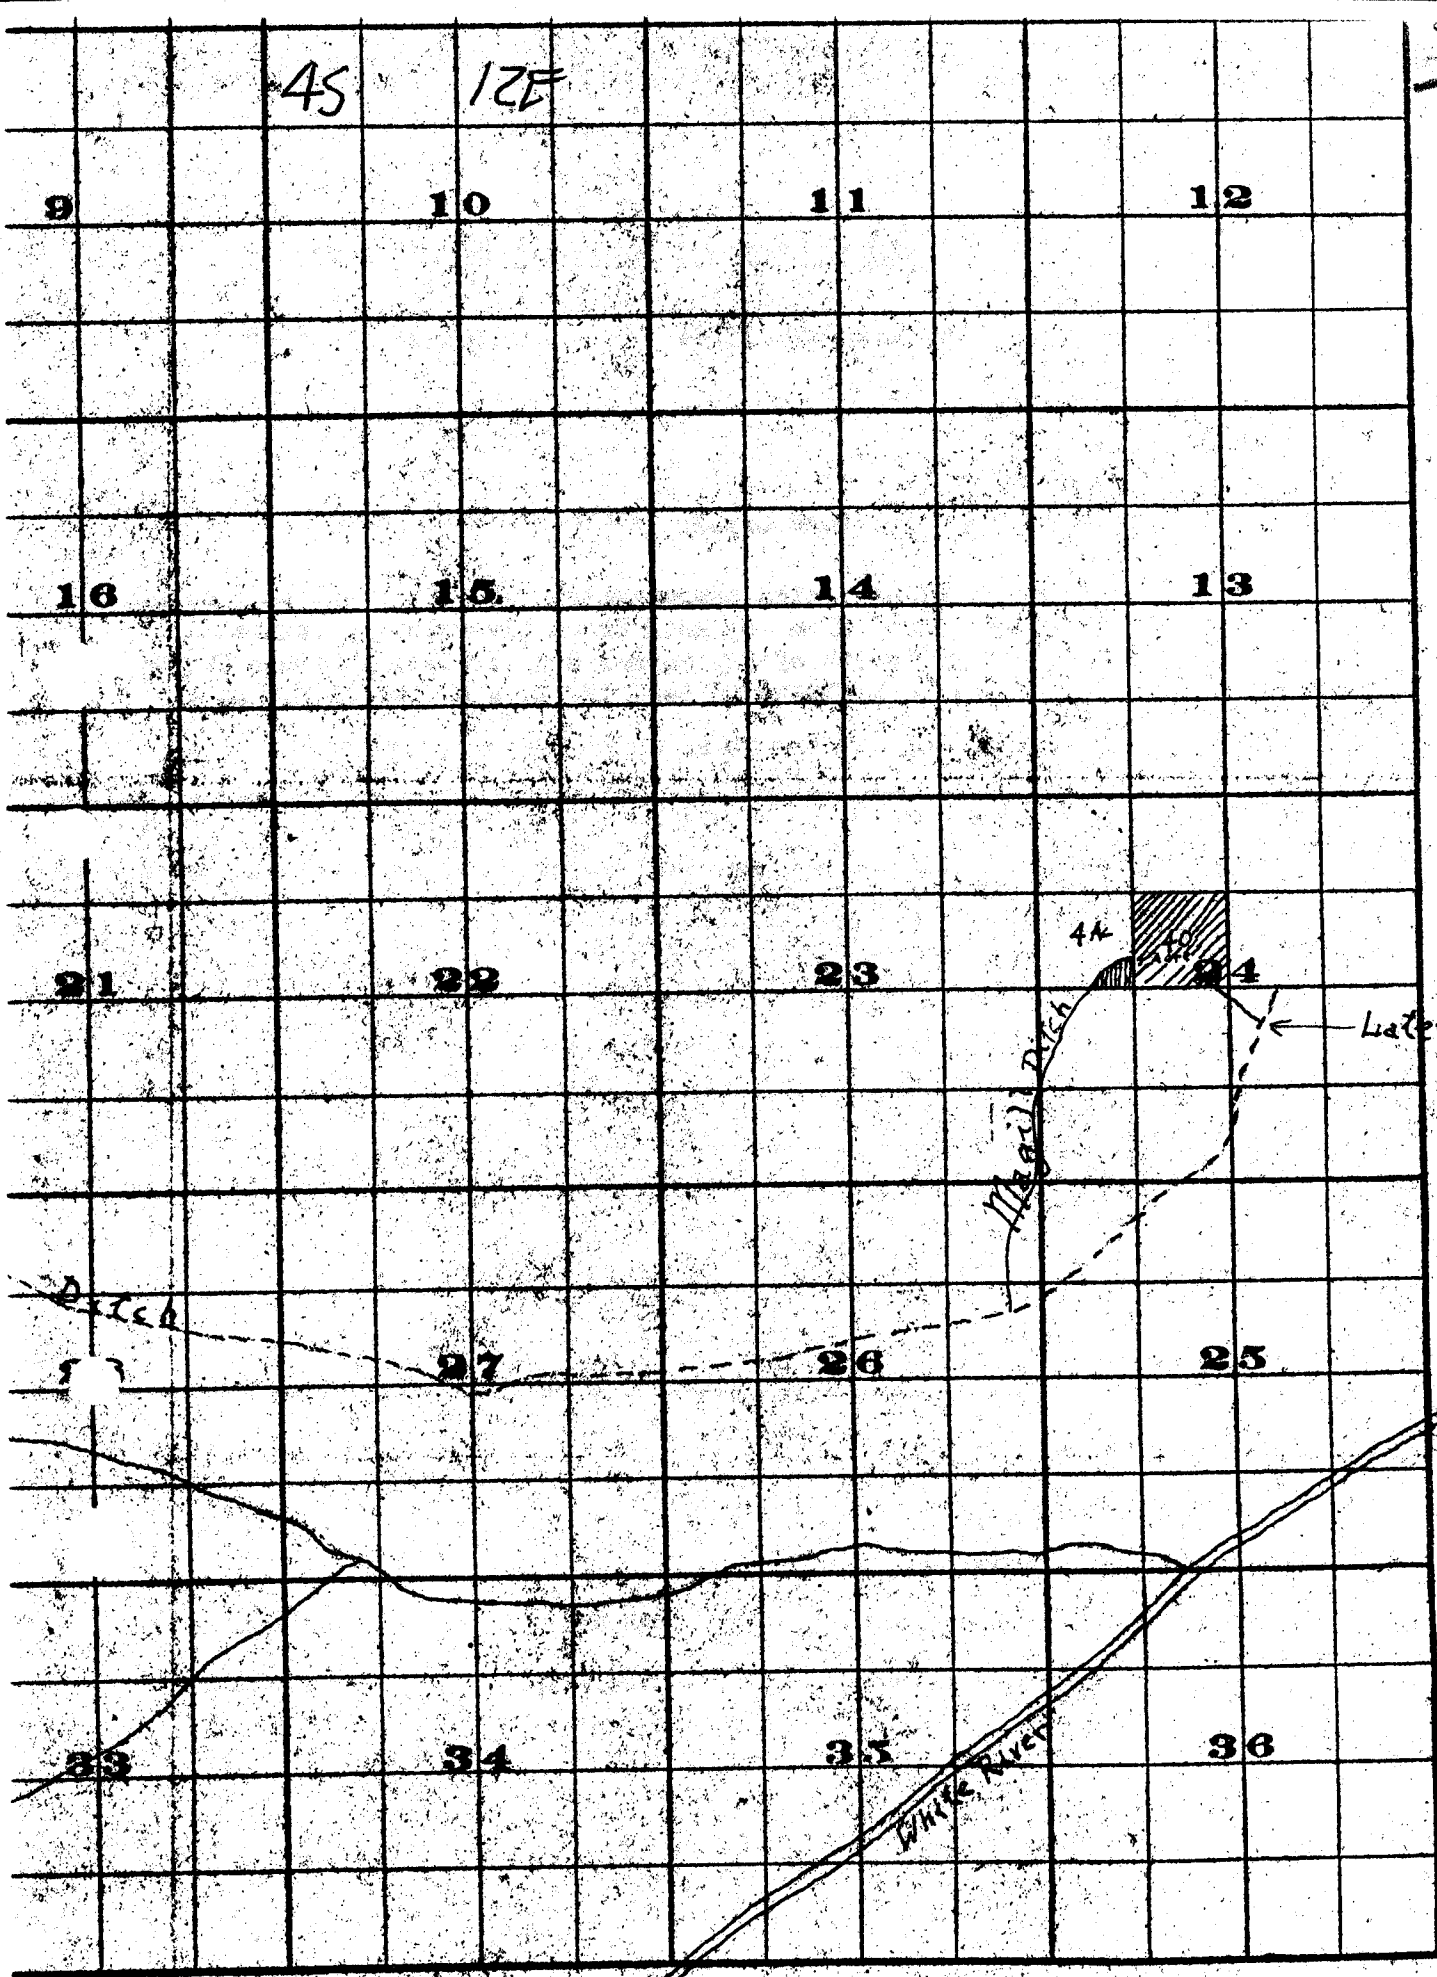

FROM OFFICE OF THE STATE ENGINEER, SALEM, OREGON  
 DIVISION NO. 384

Permit No. 8027