


RECEIVED

BENEFICIAL USE

IN THE NAME OF: JOHN BURROWS
LOT 1400, SEC. 18, T 27 S, R 11 W, WM WATER RESOURCES DEPT.
SALEM, OREGON

JUL 30 1999

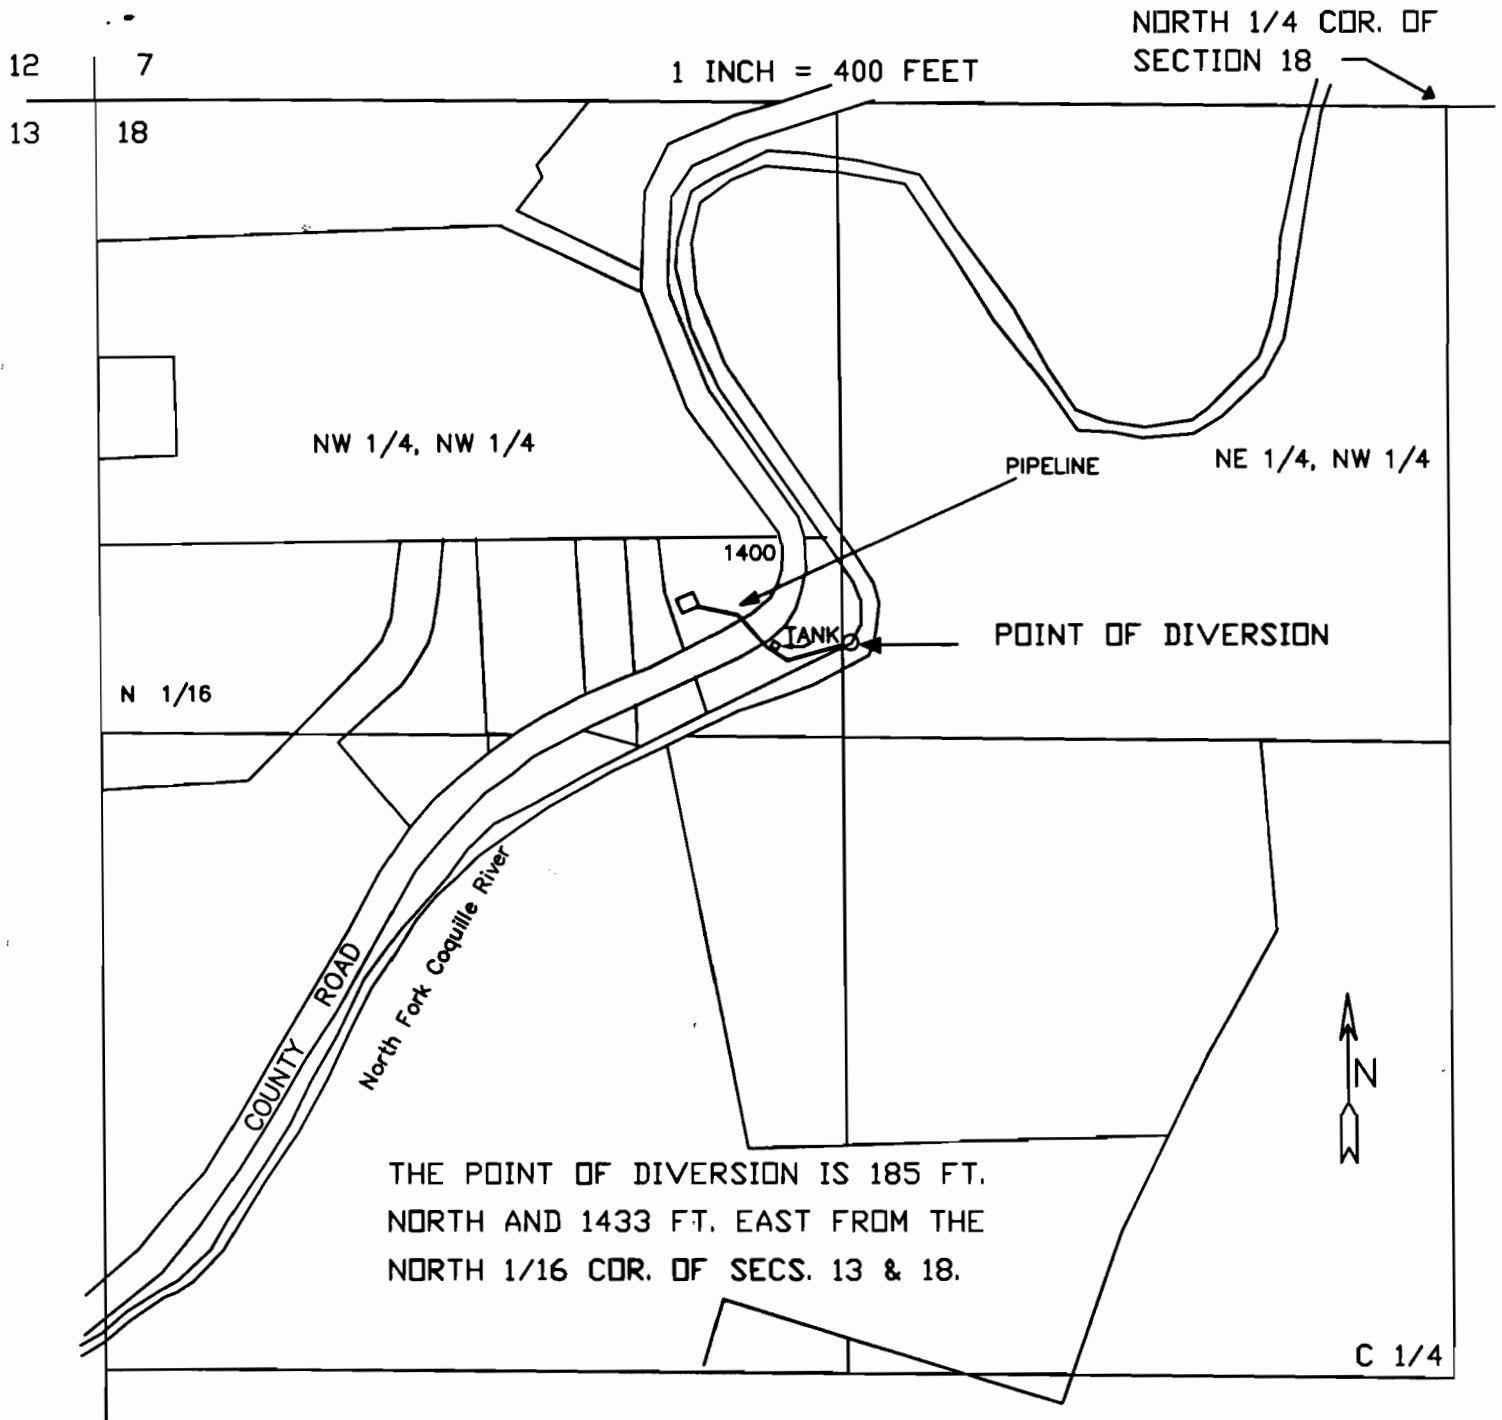

THE PURPOSE OF THIS MAP IS TO IDENTIFY THE LOCATION OF THE WATER RIGHT. IT IS NOT INTENDED TO PROVIDE INFORMATION RELATIVE TO THE LOCATION OF PROPERTY OWNERSHIP BOUNDARY LINES.

SURVEYED MARCH 21, 1998
APPLICATION NO. S-73055
PERMIT NO. 52611

Barbara Peterson
4/19/1998