



# CLAIM OF BENEFICIAL USE FINAL PROOF MAP

Located in the SW¼ NW¼ of Section 24,  
Township 27 South, Range 12 West, W.M.  
Coos County, Oregon  
Application S-73479 Permit S-53134

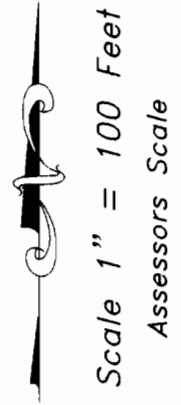

Prepared For: Robert S. Abell & Dale L. Rhoades  
Prepared By: Dennis Goude  
Date Prepared: July 24, 2004

LEGEND  
P.O.B.   
P.O.D.   
PIPE 

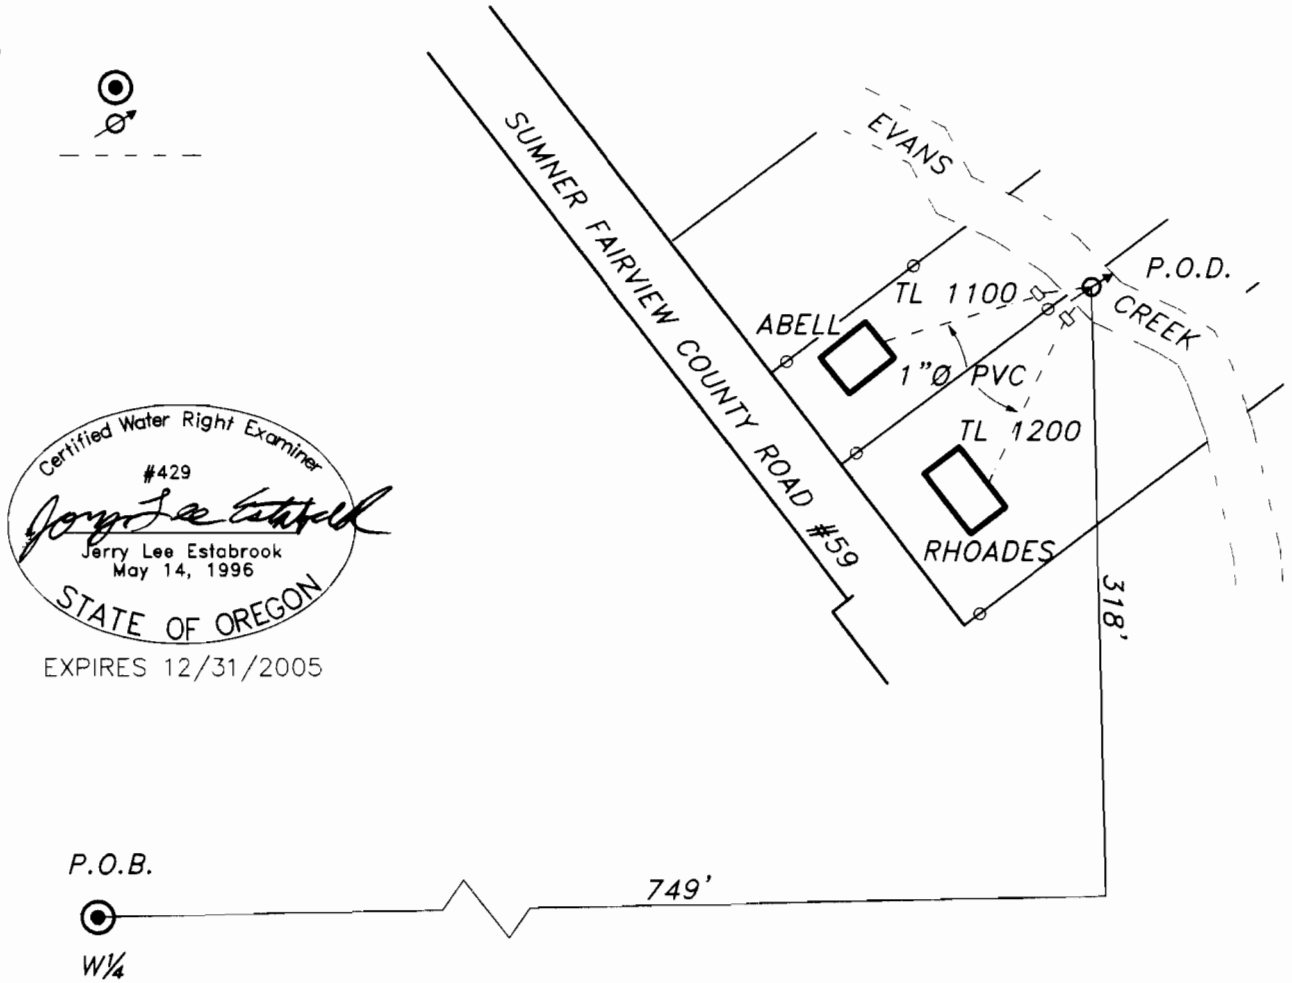

  
 EXPIRES 12/31/2005

**NOTE:**  
THE P.O.D. IS AN INSTREAM  
SCREENED PLASTIC INTAKE  
DEVICE LOCATED 749 FEET  
EAST AND 318 FEET NORTH  
FROM THE WEST ¼ CORNER  
OF SECTION 24.

**RECEIVED**

SEP 08 2004

WATER RESOURCES DEPT.  
SALEM OREGON

EXAMINERS DISCLAIMER STATEMENT  
The preparation of this map was for the purpose of  
identifying the location of the Water Right only and  
has no intent to provide dimensions or location of  
property ownership lines.

*Stuntzner Engineering  
& Forestry, L.L.C.*

ENGINEERING • LAND SURVEYING • FORESTRY  
PLANNING • WATER RIGHTS  
705 South 4th St.  
Post Office Box 118  
Coos Bay, Oregon 97420  
Phone: (541) 267-2872  
Fax: (541) 267-0588