


T.4N., R.10W., W.M.  
SECTION 6

RECEIVED

JUL 10 2002

WATER RESOURCES DEPT.  
SALEM, OREGON

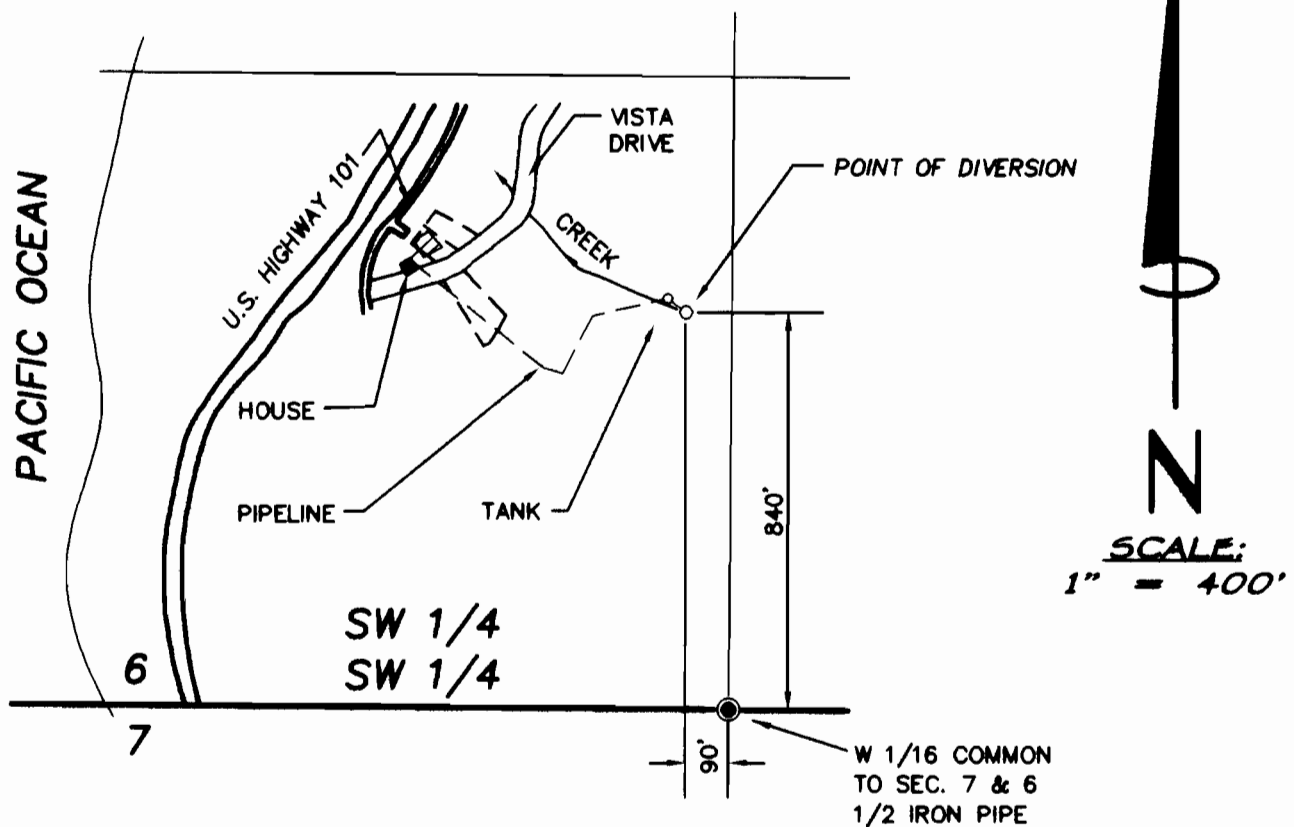

SCALE:  
1" = 400'

FINAL PROOF SURVEY

UNDER


APPLICATION NO. 73815

PERMIT NO. 51612

IN THE NAME OF

RICHARD GRUETTER

SURVEYED JUNE 4, 2002

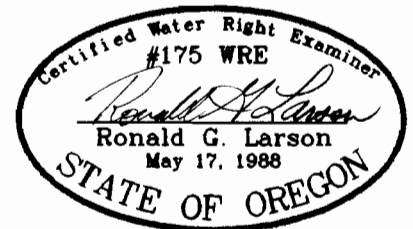

RENEWAL DATE: DECEMBER 31, 2002

FILE: 714-3985-02-01.DWG

**HLB & ASSOCIATES, INC.**  
SURVEYING • ENGINEERING • PLANNING

160 LANEDA AVE.  
MANZANITA, OR 97130  
(503) 368-5394  
FAX: (503) 368-5847

4253A HWY 101 N.  
GEARHART, OR 97138  
(503) 738-3425  
FAX: (503) 738-7455