


T. 11S., R. 40E., W.M.

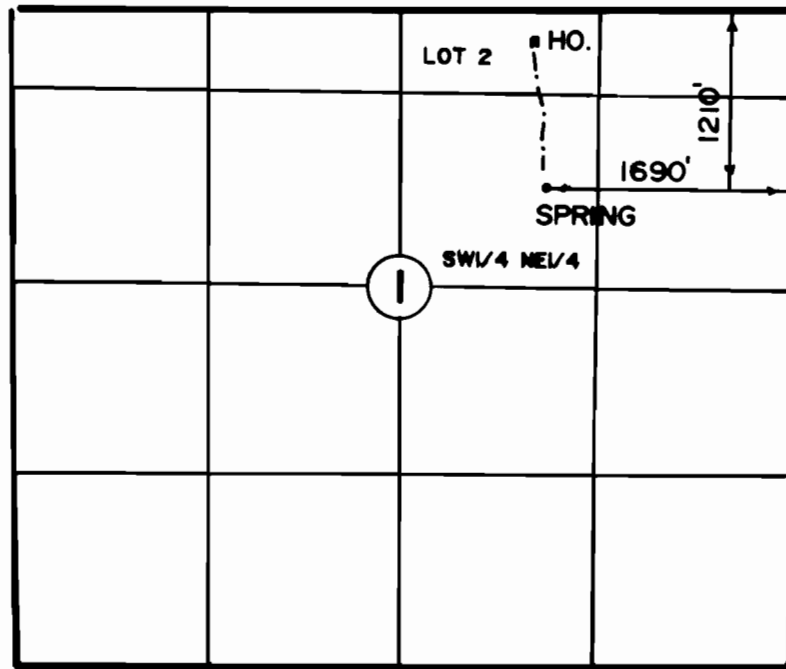

The purpose of this map is for identifying the location of the water right only and is not intended to provide legal dimensions of property ownership lines.

FINAL PROOF SURVEY

APPL. 73603

PER. 52691

IN NAME OF

Dwight & Cheryl Berglund

Surveyed Aug. 24, 2000

SCALE 1" = 1320'

RECEIVED

SEP 11 2000

WATER RESOURCES DEPT.
SALEM, OREGON

