


T6N, R5W, W.M.  
SECTION 30  
the SW 1/4 NE 1/4

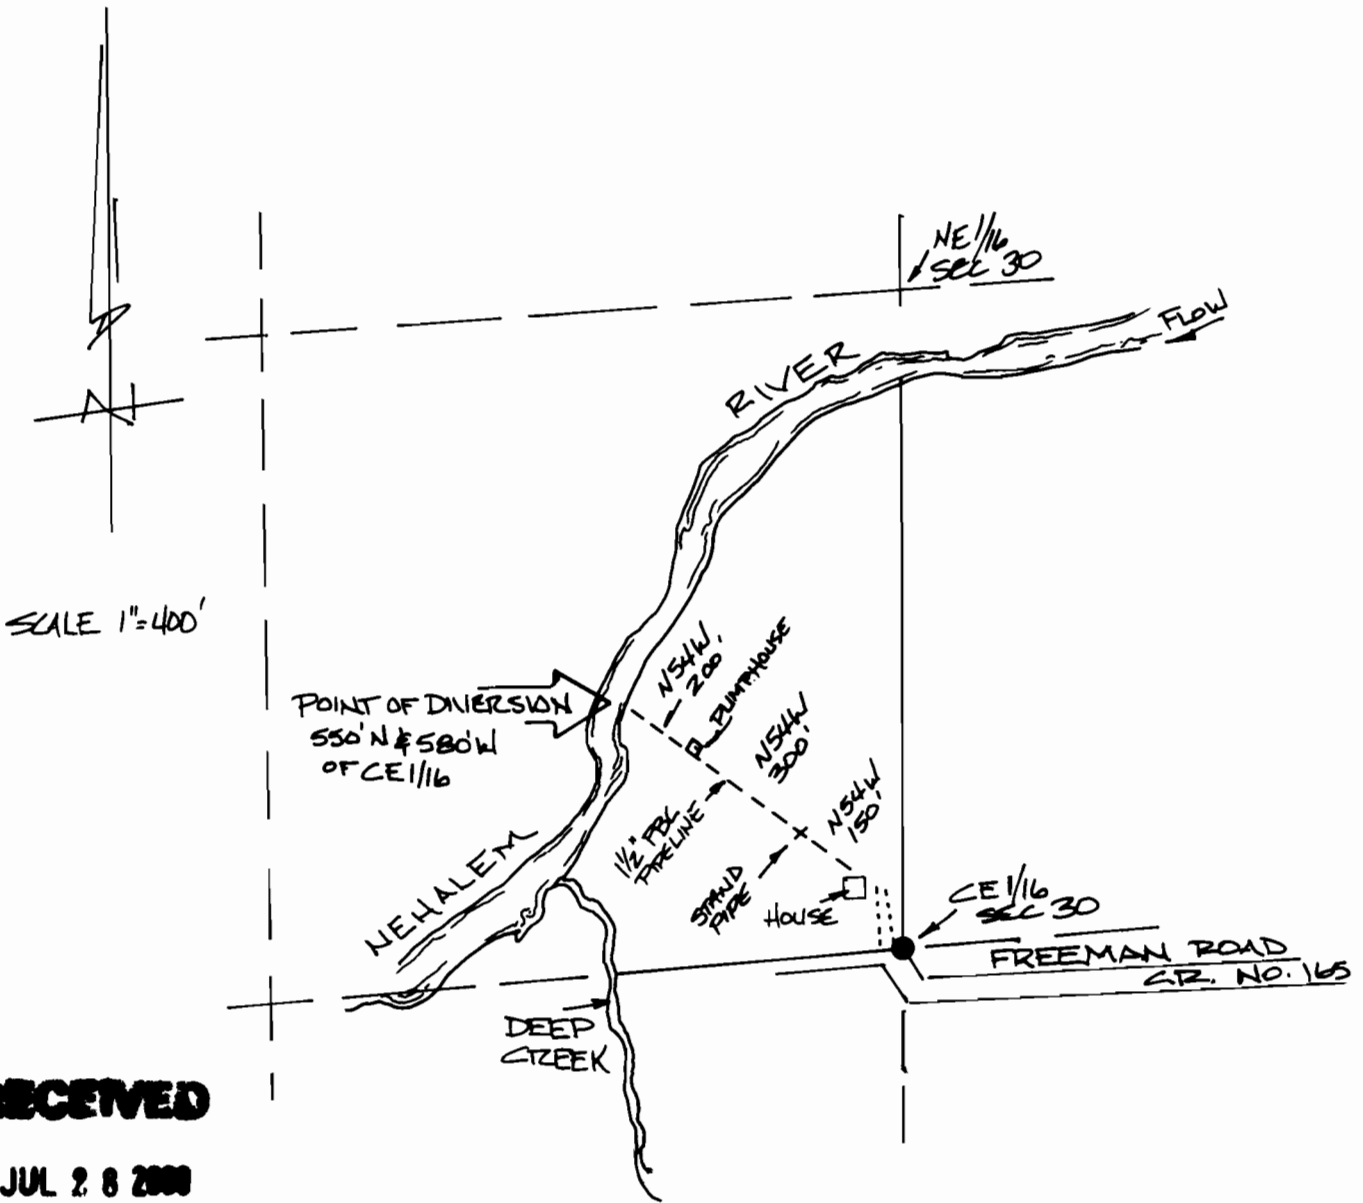

**RECEIVED**

JUL 28 2000

WATER RESOURCES DEPT.  
SALEM, OREGON

Survey by:  
LESLIE & KEENON  
1224 ALDER ST.  
VERNONIA, OREGON  
97064

July 8, 2000

FINAL PROOF SURVEY  
under - APPLICATION # S-74323  
PERMIT # 52881



For:  
EARNEST G. BOOKER  
10751 FREEMAN RD.  
BIRKENFELD, ORE.  
97016