

FINAL PROOF OF SURVEY

UNDER APP. S - 73081 PERMIT 52693



IN THE NAME OF JACK AND JESSIE FEENEY

LOCATED IN

**RECEIVED** SW 1/4 NE 1/4 SEC. 24, T. 40 S., R. 13 W., W.M.

SEP 12 2000

WATER RESOURCES DEPT.  
SALEM, OREGON

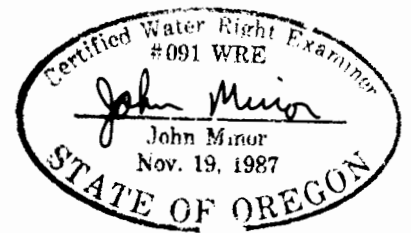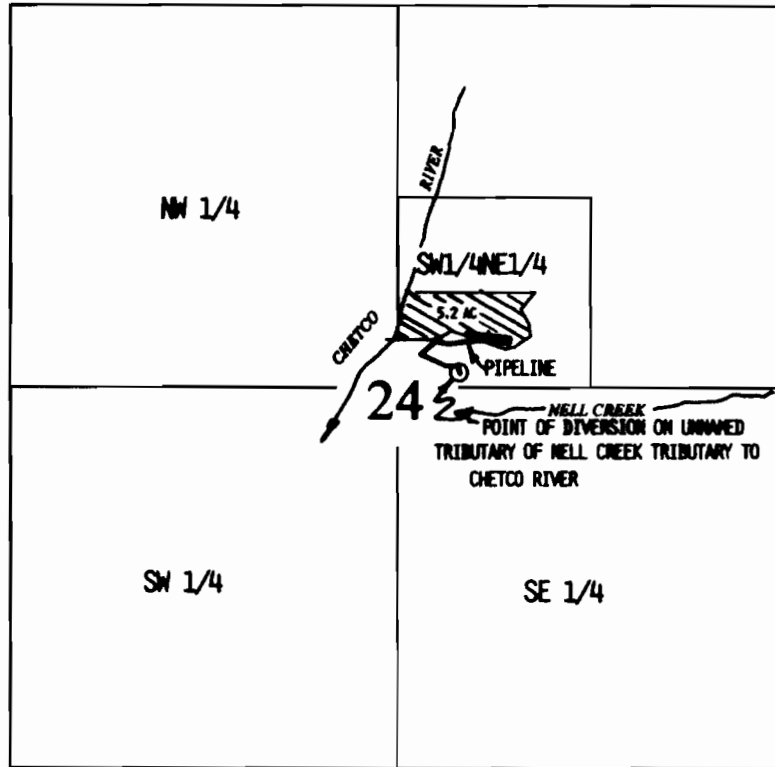

N

SCALE: 1" = 1320'

THE PURPOSE OF THIS MAP IS TO IDENTIFY THE LOCATION OF THE WATER RIGHT. IT IS NOT INTENDED TO IDENTIFY PROPERTY OWNERSHIP. FINAL PROOF SURVEY PERFORMED 8-16-2000 POINT OF DIVERSION LIES 107' N & 2060' W OF THE E 1/4 CORNER OF SEC. 24