



RECEIVED

JUL 22 1996

WATER RESOURCES DEPT.
SALEM, OREGON

T5N, R2W, W.M.
THE SE1/4 SEC 21 & SW1/4 SEC 22
COLUMBIA COUNTY, ORE.
SCALE 1"=400' 7/12/96

FINAL PROOF SURVEY MAP
PERMIT # 52050

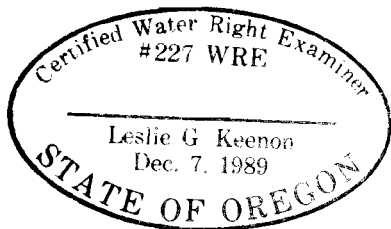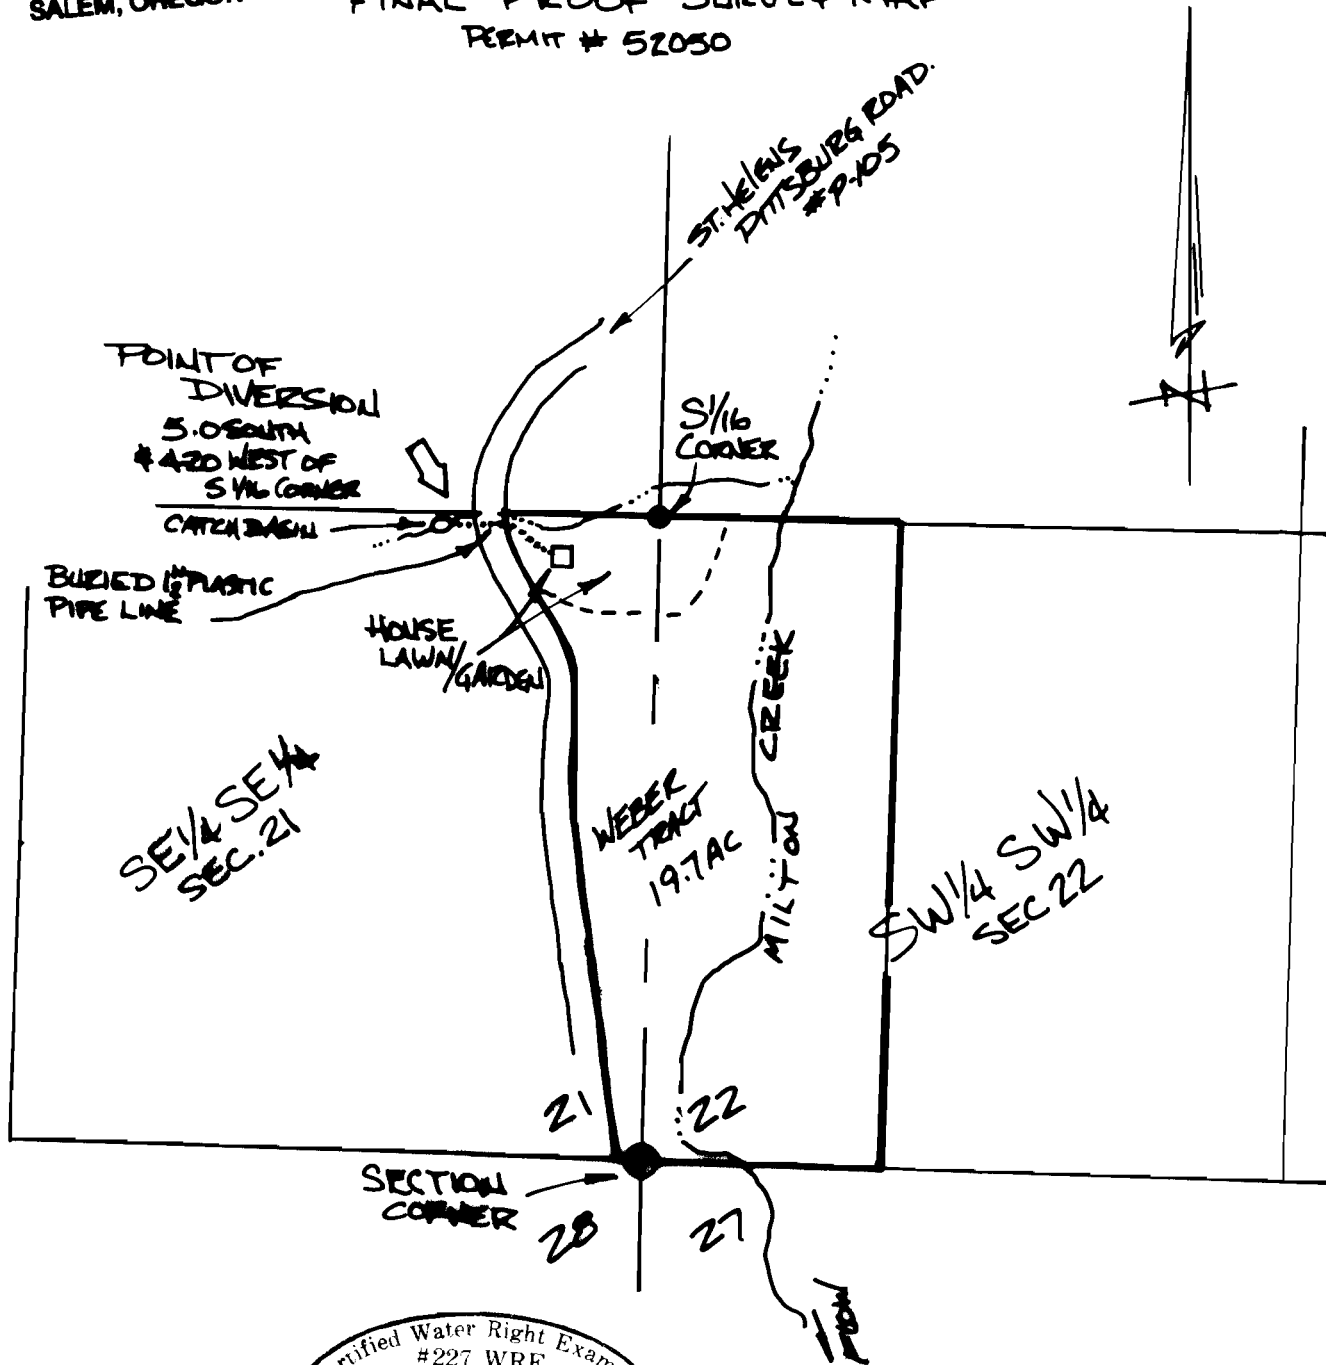

L. JERRY KEENON
1224 ALDER ST.
VERNONIA, ORE.
97064

(503) 429-6115