

CLAIM OF BENEFICIAL USE
FINAL PROOF MAP

Located in the SE $\frac{1}{4}$ NE $\frac{1}{4}$ of Section 1,
Township 29 South, Range 13 West, W.M.
Coos County, Oregon

Application S-73941 Permit 52107

1000 Gal. Storage
Tank & 1 HP pump

Prepared For: Louis McCarthy
Prepared By: Dennis Goude
Date Prepared: August 10, 2000

NOTE:
Garden is irrigated with
hose and sprinkler.

LEGEND
P.O.B.
P.O.D.
IRRIGATED
AREA

Garden Area
0.5 acres

Residence

Myrtle Point Lampa
358' of
1" \varnothing PVC

Storage Tank
10'x12'x6'

1221' of
1 $\frac{1}{4}$ " \varnothing PVC

SE $\frac{1}{4}$ NE $\frac{1}{4}$


E $\frac{1}{4}$

Tributary
to
Hall Creek

P.O.D.

NOTE:
THE P.O.D. IS A 7' X 12' X 5'
CONCRETE TANK FED BY A SHORT
SECTION OF 3" \varnothing PLASTIC PIPE.
THE P.O.D. IS LOCATED 860 FEET
WEST AND 922 FEET NORTH OF
THE SOUTH 1/16 CORNER OF
SECTION 1.

Scale 1"=400'

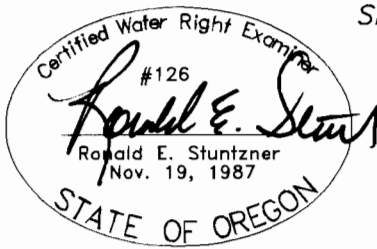

RECEIVED

SEP 25 2000

WATER RESOURCES DEPT
SALEM, OREGON

NE $\frac{1}{4}$ SE $\frac{1}{4}$

POINT OF
BEGINNING

Section 1
Section 6

922'

S 1/16

860'

EXPIRES 06/30/02

EXAMINERS DISCLAIMER STATEMENT

The preparation of this map was for the purpose of
identifying the location of the Water Right only and
has no intent to provide dimensions or location of
property ownership lines.

Stuntzner Engineering
& Forestry, L.L.C.

ENGINEERING • LAND SURVEYING • FORESTRY
PLANNING • WATER RIGHTS

705 South 4th St.
Post Office Box 118
Coos Bay, Oregon 97420

Phone: (541) 267-2872
Fax: (541) 267-0588