


RECEIVED

DEC 04 1995

T7S. R10W., W.M.
SW 1/4 SECTION 19
LINCOLN COUNTY, OREGON

WATER RESOURCES DEPT.
SALEM, OREGON

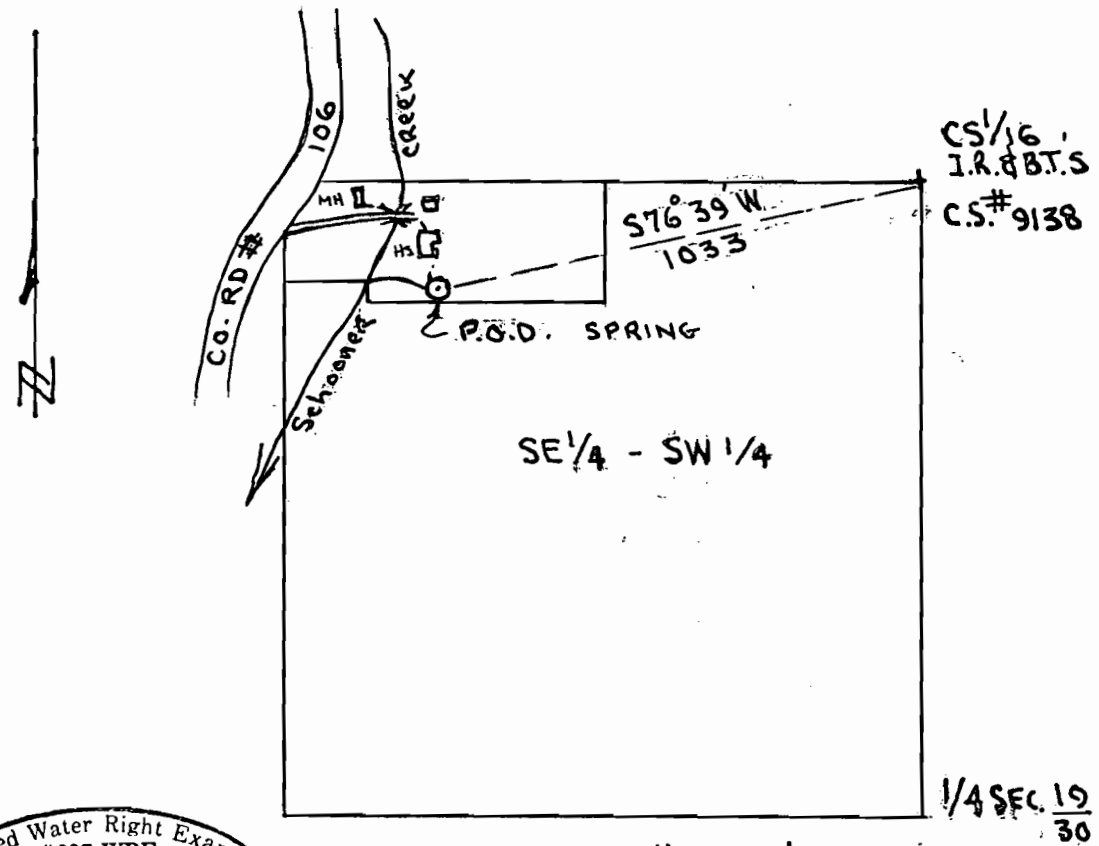

Certified Water Right Examiner
#037 WRE
James M. Denison
James M. Denison
Nov. 19, 1987
STATE OF OREGON

FINAL PROOF SURVEY
UNDER

APPLICATION #72548

PERMIT # 51605

IN THE NAME OF

TERRENCE & MILDRED KIRBY-BLAIRE

SURVEYED: SEPTEMBER 13, 1995

BY: J. M. DENISON

THIS MAP PREPARED SOLEY FOR THE PURPOSE OF SHOWING LOCATION OF A WATER RIGHT, AND IS NOT INTENDED FOR USE FOR PROVIDE DIMENSIONS OR LOCATION OF PROPERTY OWNERSHIP LINES.