


RECEIVED

T.2N., R.10W., W.M.
SECTION 9

MAY - 6 1997

WATER RESOURCES DEPT
SALEM, OREGON

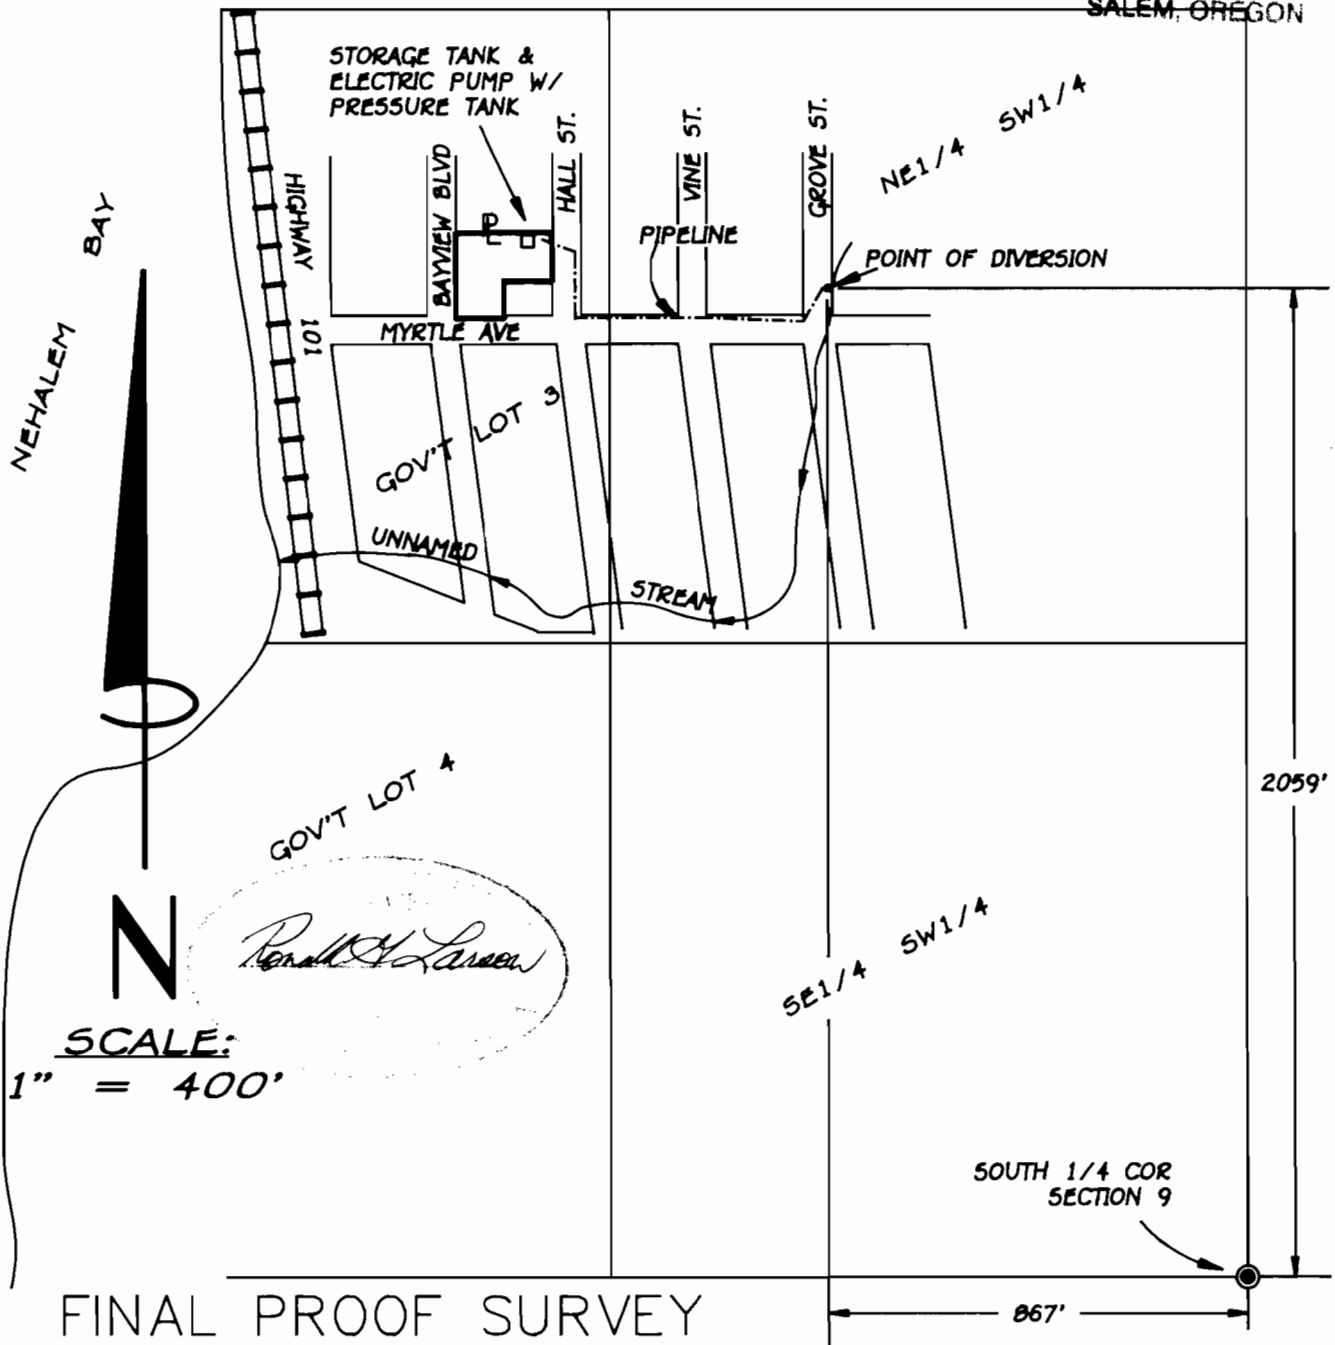

FINAL PROOF SURVEY

UNDER

APPLICATION NO. 73173, PERMIT NO. 52073

FILE: 16060201.DWG

IN THE NAME OF

T.G. DONALD

SURVEYED SEPT. 20, 1996

HLB & ASSOCIATES, INC.
SURVEYING • ENGINEERING • PLANNING

4253A HWY 101 N.
GEARHART, OR 97138
(503) 738-3425
FAX: (503) 738-7455