


RECEIVED

TOWNSHIP 40 SOUTH, RANGE 2 EAST, W.M.


AUG 05 1998

WATER RESOURCES DEPT
SALEM, OREGON

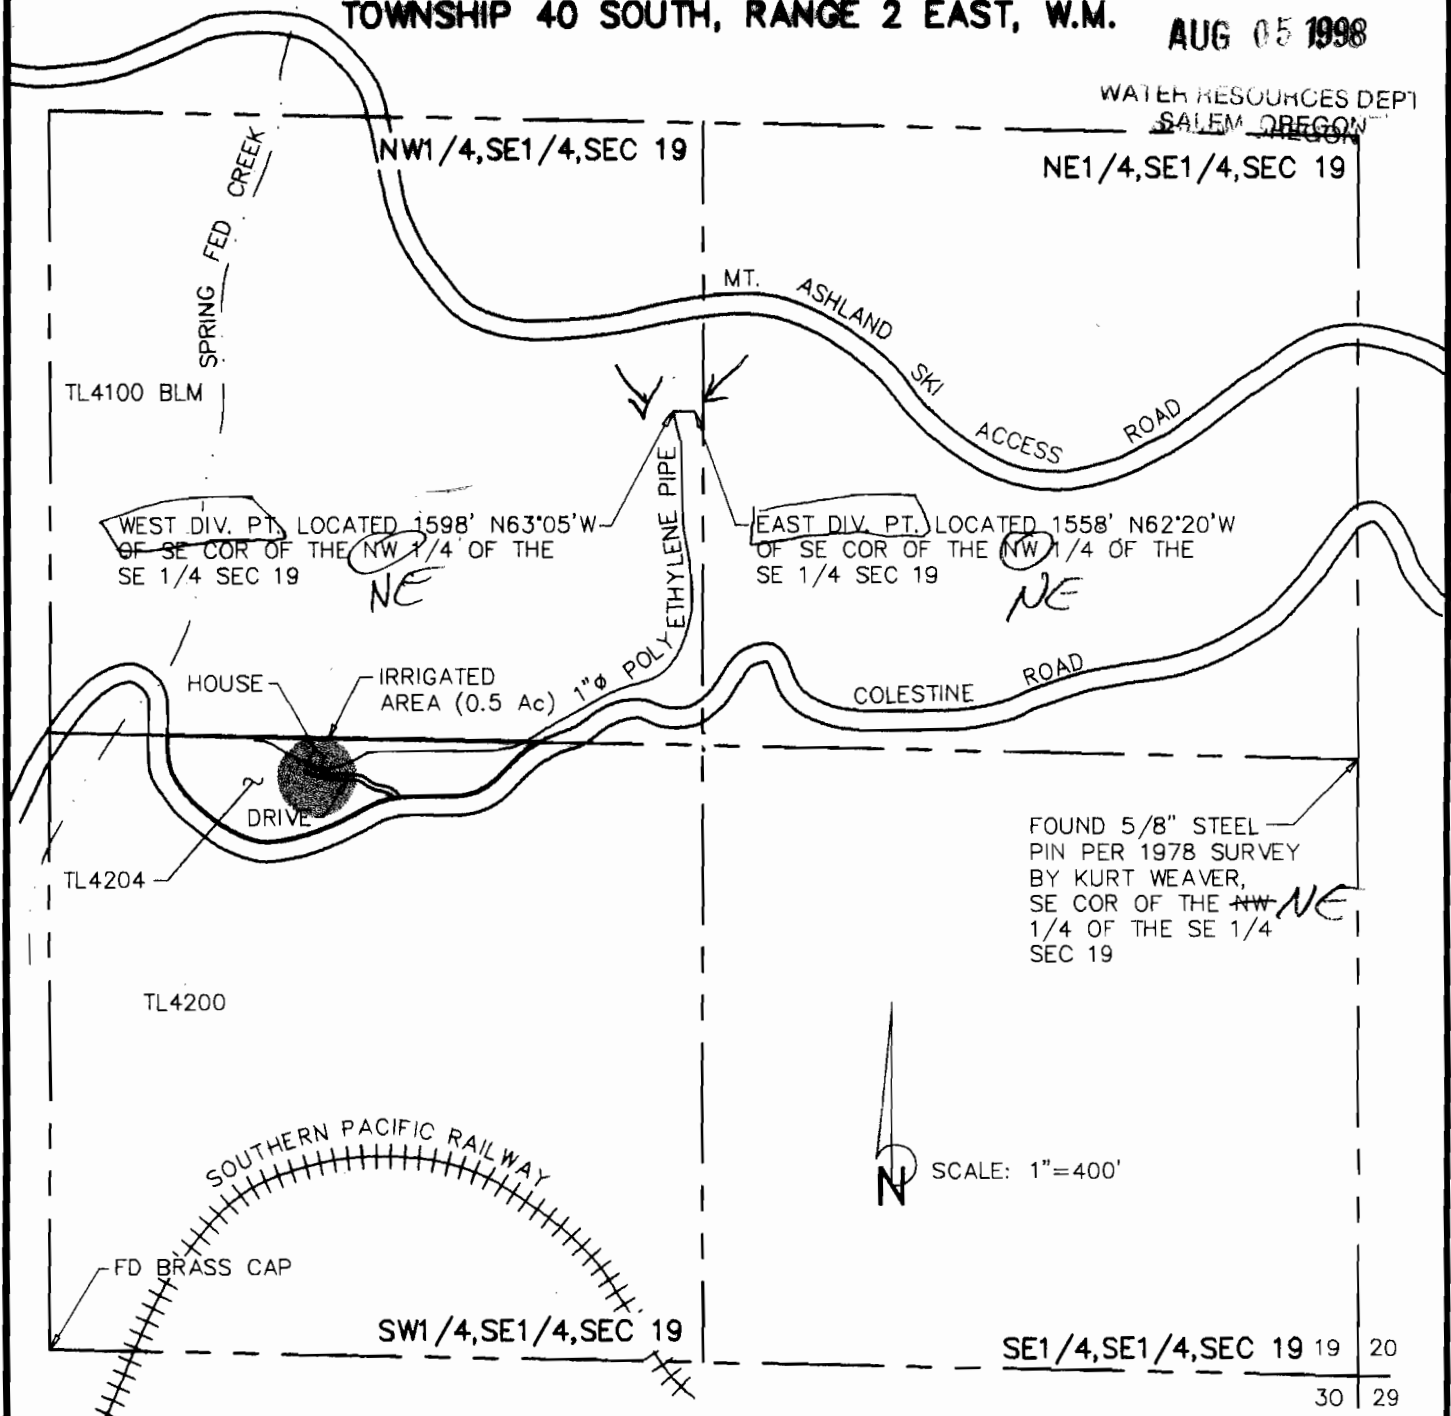

**FINAL PROOF SURVEY
UNDER**

**APPL. No. S-72241, PER No. 53256
FEB. 26, 1998**

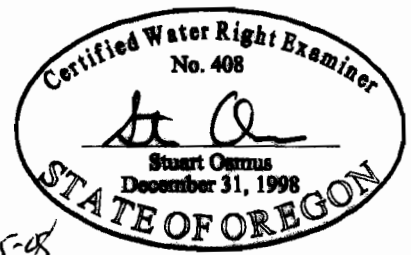

THIS MAP WAS PREPARED FOR THE
PURPOSES OF IDENTIFYING THE LOCATION
OF A WATER RIGHT ONLY AND IS NOT
INTENDED TO PROVIDE LEGAL DIMENSIONS
OR LOCATION OF PROPERTY OWNERSHIP LINES.

Amended by WRD Staff - 7-15-98

MARQUESS & ASSOCIATES, INC.

CONSULTING ENGINEERS

1120 East Jackson Street
MEDFORD, OREGON 97504

TELEPHONE: (541) 772-7115

FAX: (541) 779-4079

FINAL PROOF SURVEY

**1192 Colestine Road
ASHLAND OR**

JOB:	N/A	DATE:	2-26-98	SCALE:	DRAWING NO.
DRAWN:	ATG	CHECKED:	SMO	1"=400'	1