


T.23S.,R.4W.,W.M.

SECTION 15,22

SCALE 1" = 1320'

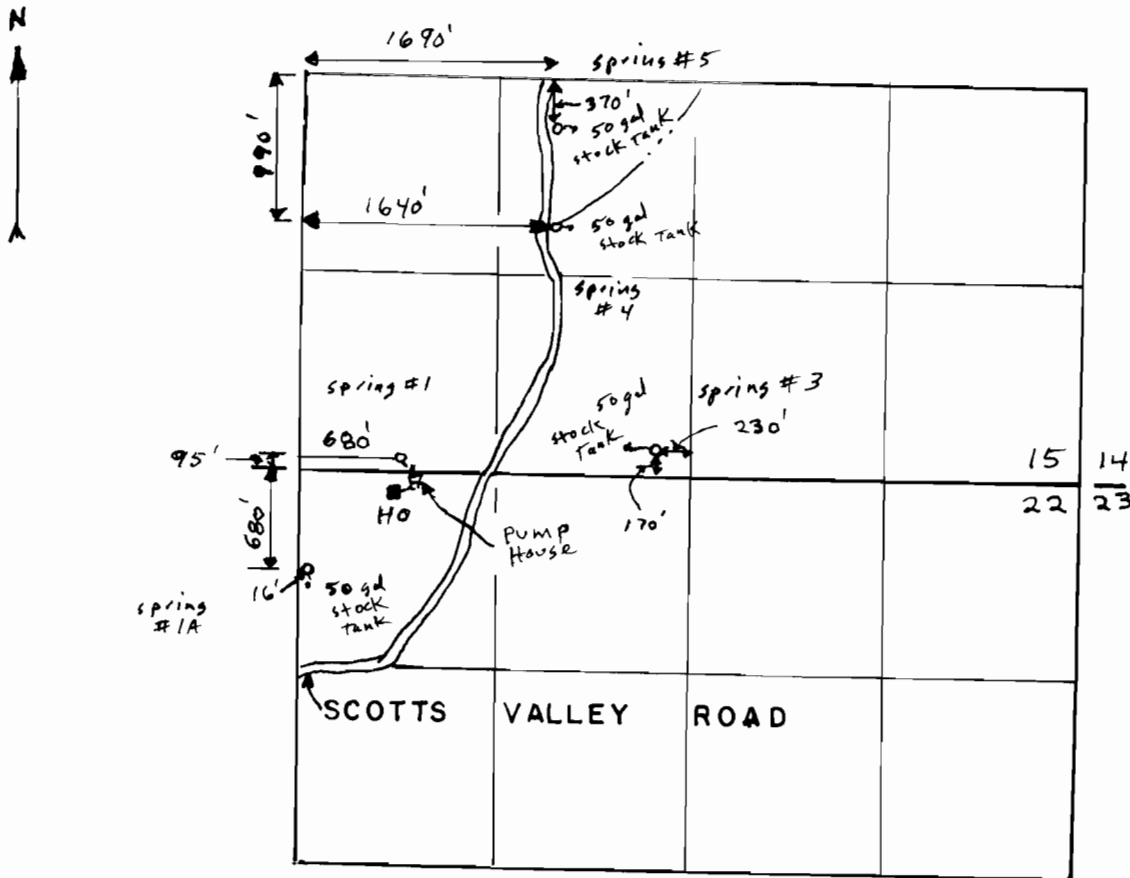

THE PURPOSE OF THIS MAP IS TO IDENTIFY THE LOCATION OF THE WATER RIGHT. IT IS NOT INTENDED TO PROVIDE INFORMATION RELATIVE TO THE LOCATION OF PROPERTY OWNERSHIP BOUNDARY LINES.

FINAL PROOF SURVEY
UNDER



Application No 71816 Permit No 51405
IN NAME OF

PERCY LANGDON

Surveyed DEC 10 1994 by DW KIRBY