T6S, R23E, W.M.,

WHEELER COUNTY, OREGON


FINAL PROOF SURVEY

FOR

Application No. 67356
Permit No. 48161

IN THE NAME OF

LARRY WADE
P.O. Box 726
Condon, OR. 97823
Phone: 384-3074

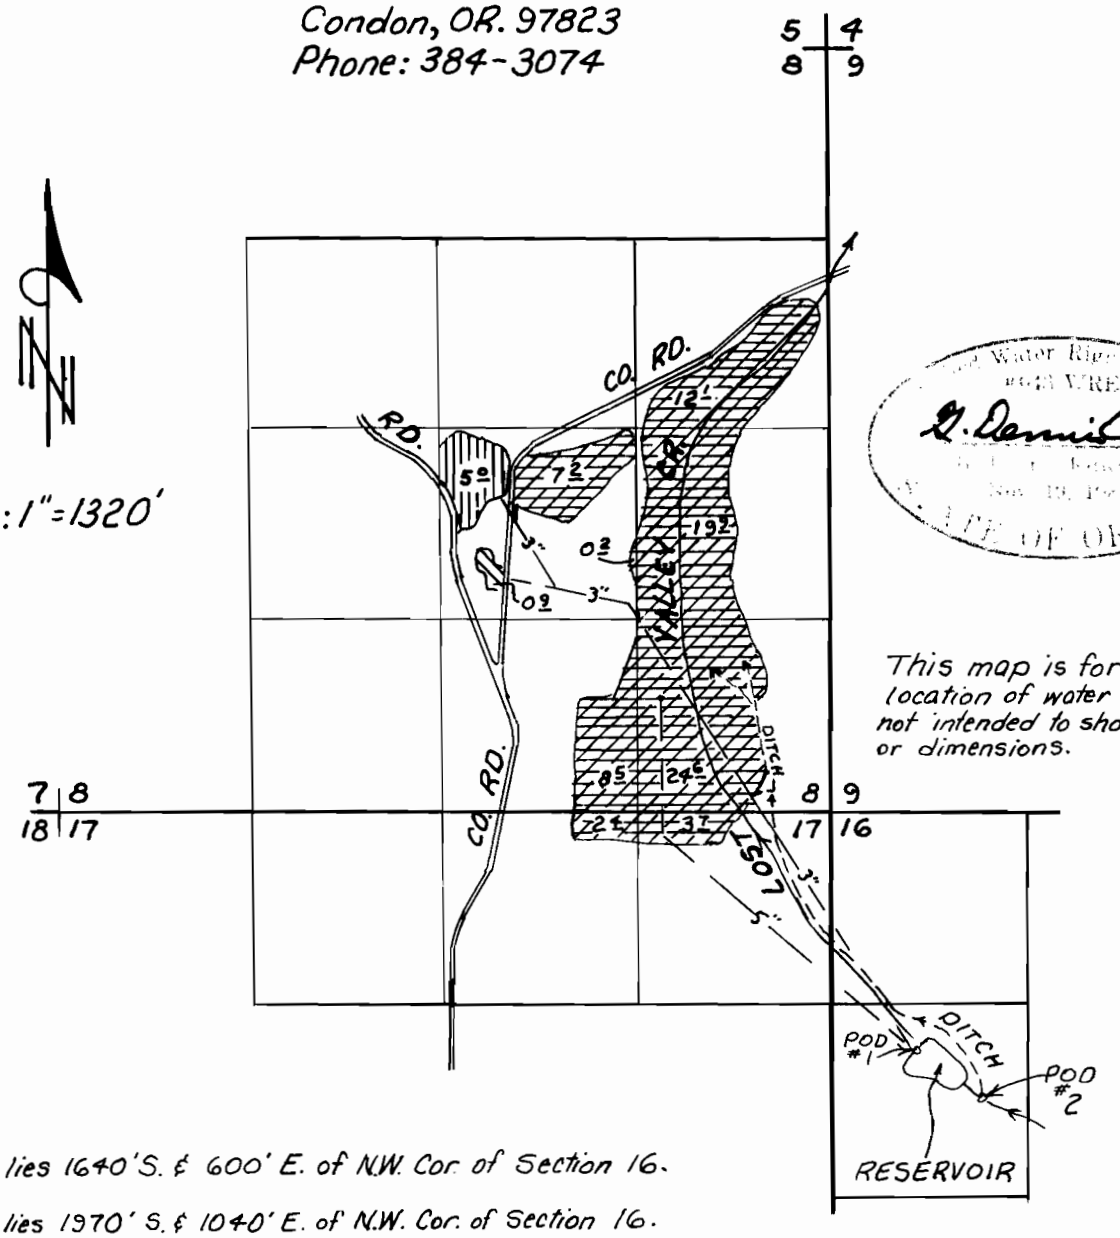

Scale: 1" = 1320'

This map is for identifying the location of water rights only and is not intended to show property lines or dimensions.

POD #1 lies 1640' S. & 600' E. of N.W. Cor. of Section 16.

POD #2 lies 1970' S. & 1040' E. of N.W. Cor. of Section 16.

APPLICATION #67356
PERMIT #48161

Lawn & Garden

Feed Lot

Rev. 11/14/94

Edwards Surveying P.O. Box 763
567-3336 Hermiston, OR. 97838

8/31/92 Job #W9205035