


 


T. 1 N., E. 32 E., W. M.



-  T - 5808 Priority 1894
-  T - 5795 Priority 1873
-  T - 5795 Priority 1889
-  T - 5795 Priority 1900

**FINAL PROOF SURVEY UNDER**


T - 5795  
T - 5808

IN THE NAME OF  
**PENDLETON COUNTRY CLUB, INC.**  
Surveyed June 29, 1990, by V. Church

**RECEIVED**

APR 28 2008  
WATER RESOURCES DEPT  
SALEM OREGON

Aerial 41059-378-19L  
1994 NAPP 7013 72 HI  
Drafted 4-01-2008 by J Miller

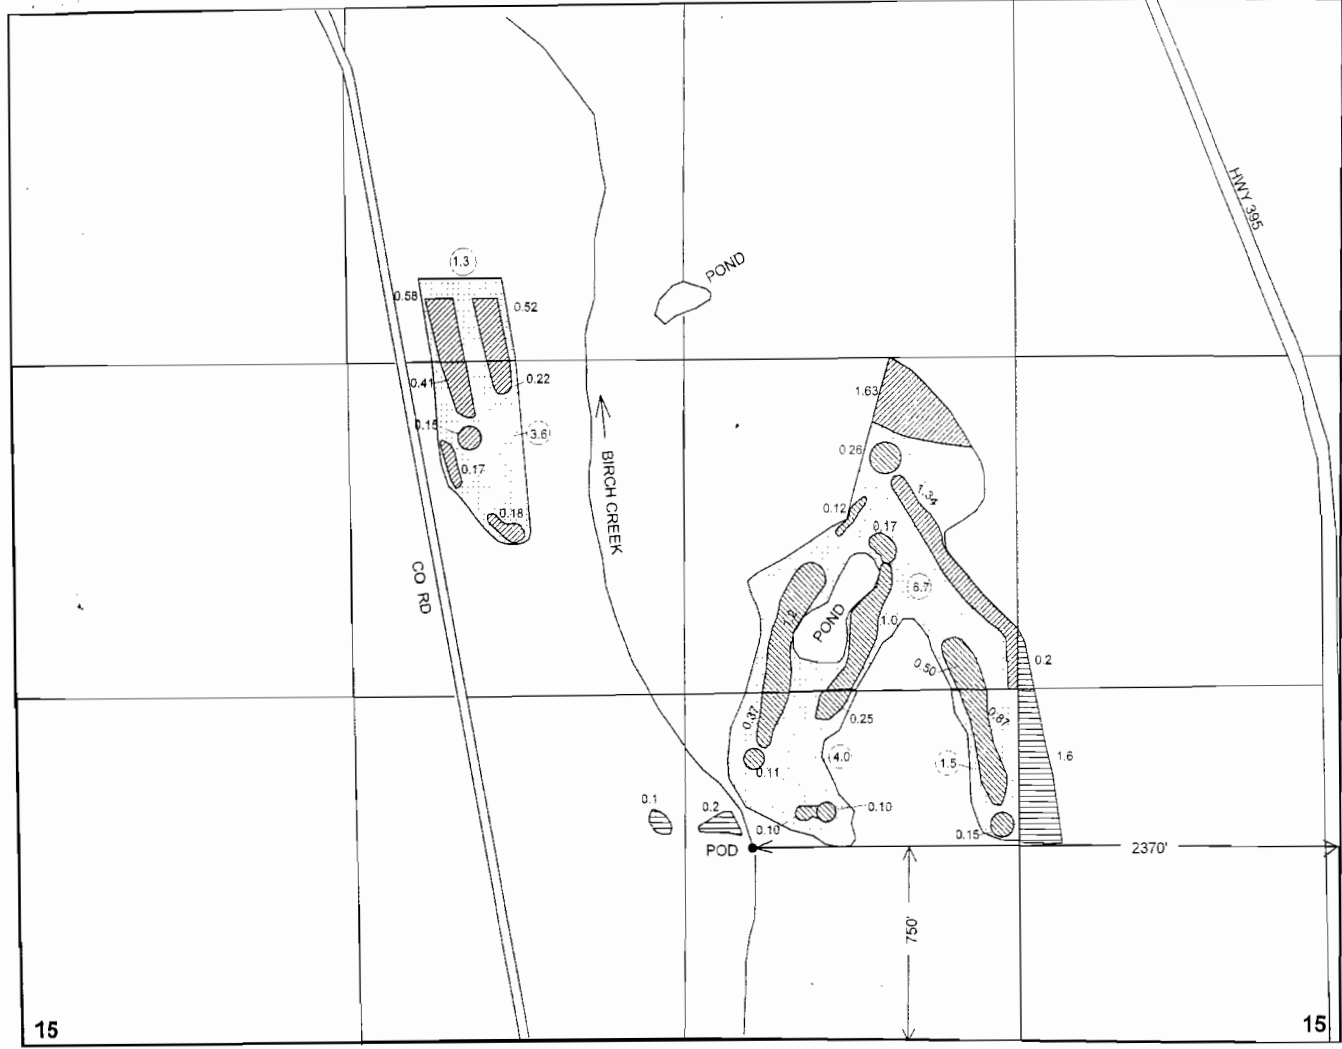

15

15