



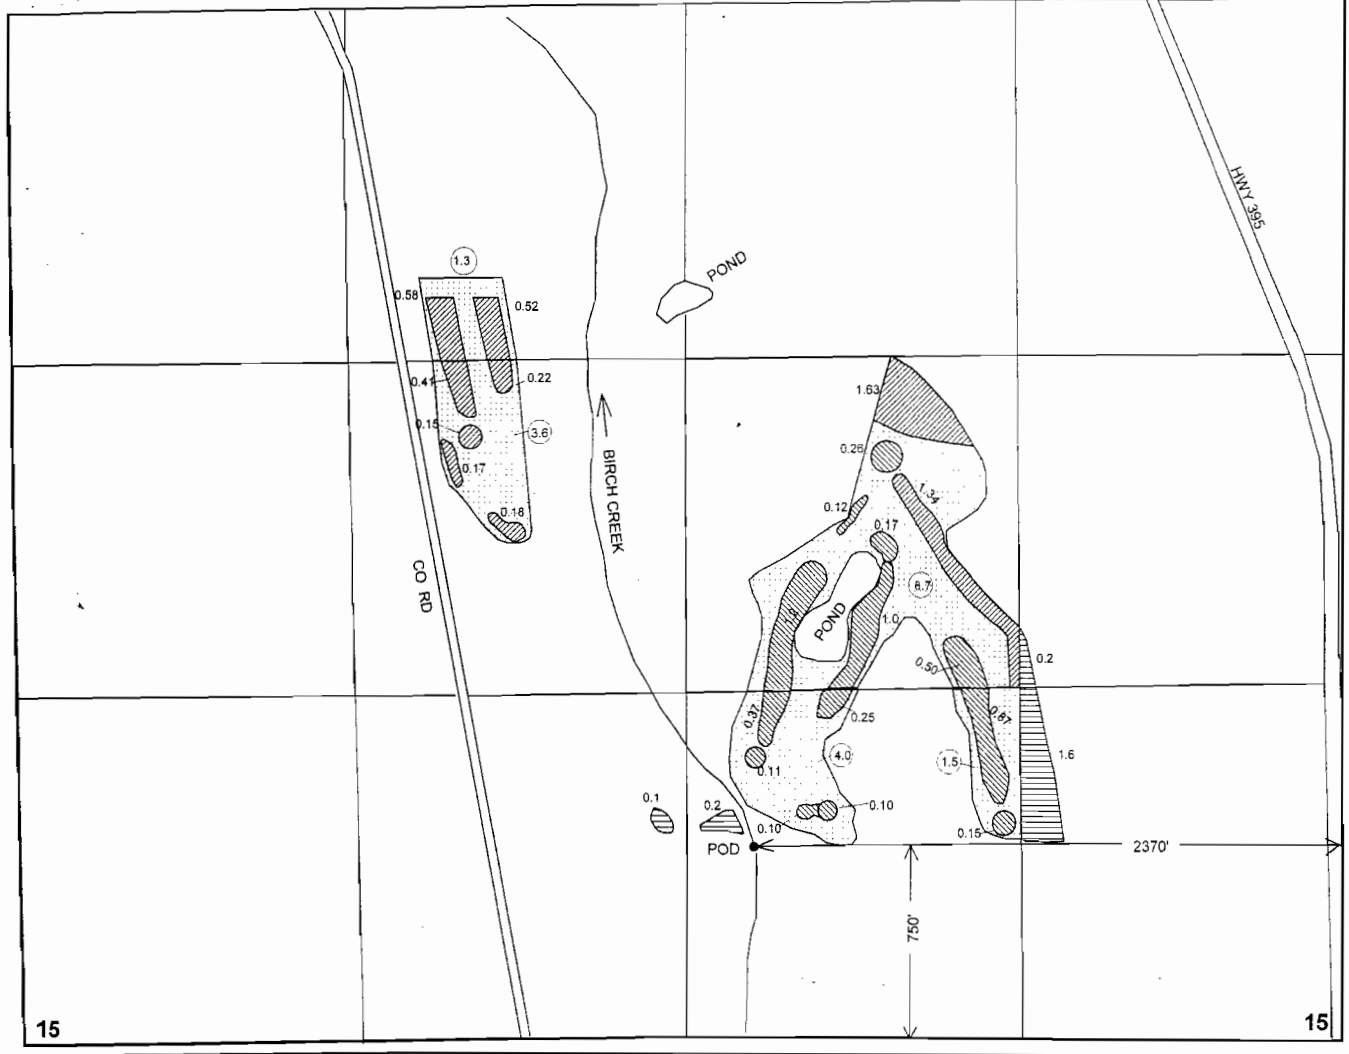


T. 1 N., E. 32 E., W. M.

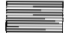

-  T - 5808 Priority 1894
-  T - 5795 Priority 1873
-  T - 5795 Priority 1889
-  T - 5795 Priority 1900

**FINAL PROOF SURVEY
UNDER**
T - 5795
T - 5808
**IN THE NAME OF
PENDLETON COUNTRY CLUB, INC.**
Surveyed June 29, 1990, by V. Church

RECEIVED
APR 28 2008
WATER RESOURCES DEPT
SALEM OREGON

Aerial 41059-378-19L
1994 NAPP 7013 72 HI
Drafted 4-01-2008 by J. Miller