


FINAL PROOF SURVEY MAP LOCATED
IN SE1/4 SW1/4 OF SECTION 12 AND IN
NE1/4 NW1/4 OF SECTION 13, T.16S., R.16E.,
W.M., CROOK COUNTY, OREGON
W.O. 07-3591

COBU MAP # 0334

RECEIVED

JUN 14 2007

WATER RESOURCES DEPT
SALEM, OREGON

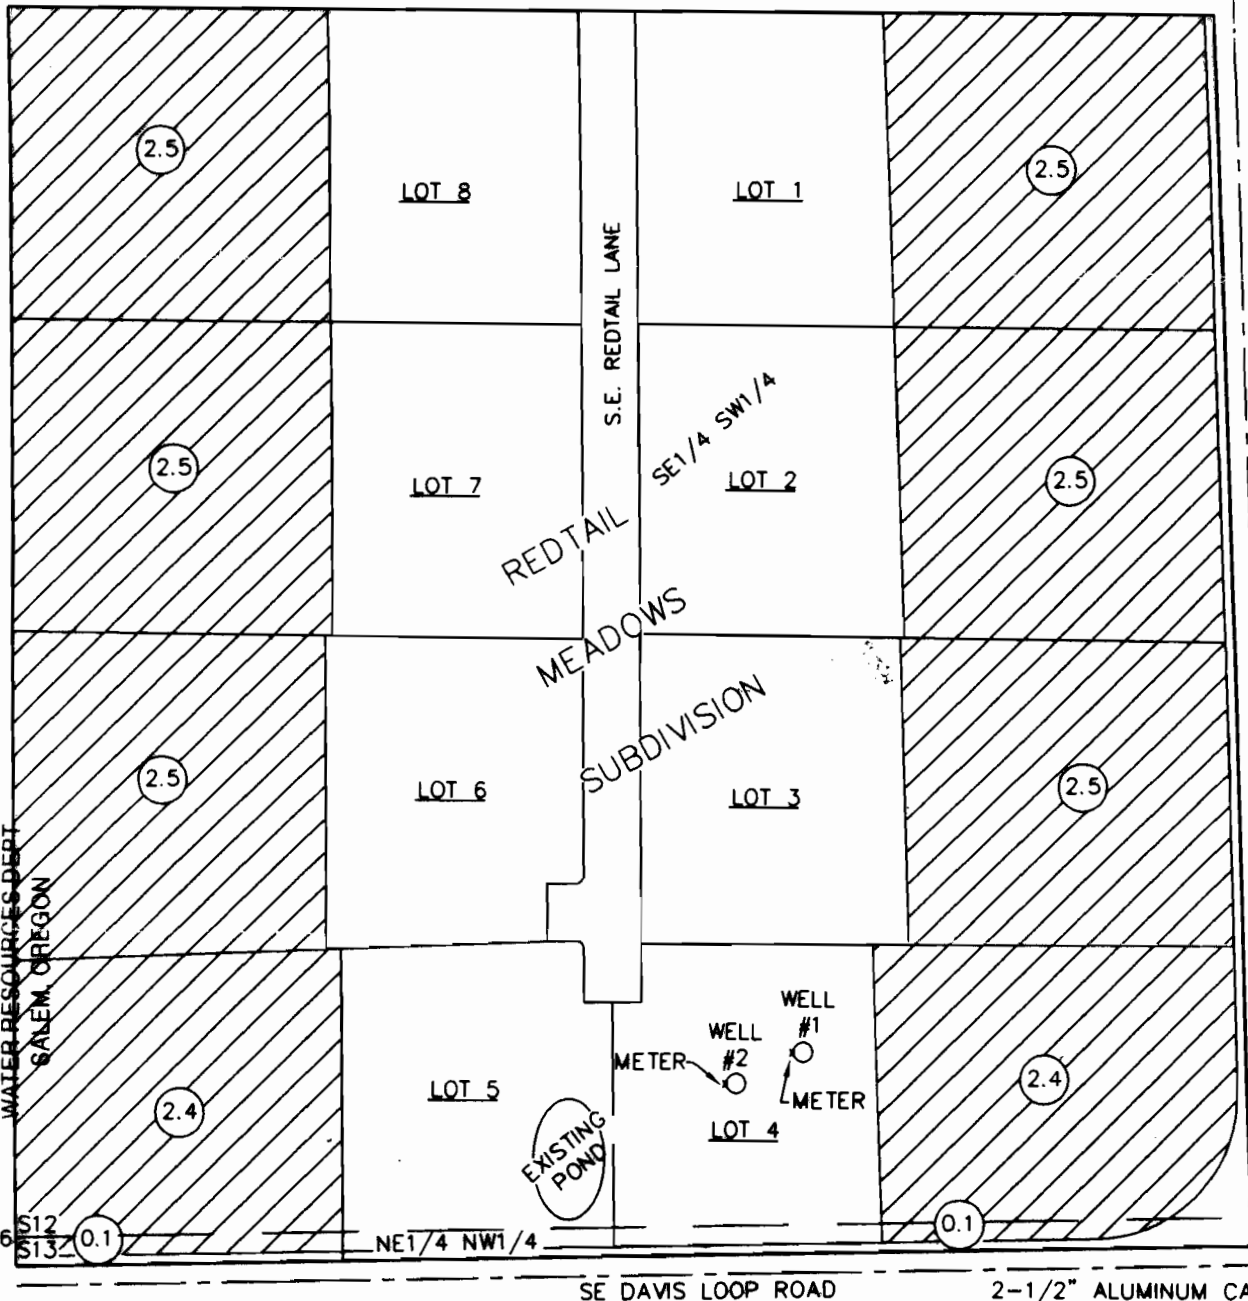

SURVEYED FOR SURVEYED BY

RIVERS BEND DEVELOPMENT, LLC
C/O BROOK HAVENS, MEMBER
5055 NE MCKAY CREEK RD.
PRINEVILLE, OR 97754
(541) 447-1682

ARMSTRONG SURVEYING
& ENGINEERING, INC
267 NE SECOND ST. STE 100
PRINEVILLE, OR. 97754
(541) 447-7791

WELL LOCATIONS

WELL #1 - LOCATED IN SE1/4 SW1/4 SECTION 12, T.16S.,
R.16E., W.M., 178 FT. NORTH AND 510 FT.
WEST OF THE S1/4 CORNER SECTION 12.


WELL #2 - LOCATED IN SE1/4 SW1/4 SECTION 12, T.16S.,
R.16E., W.M., 147 FT. NORTH AND 581 FT.
WEST OF THE S1/4 CORNER SECTION 12.

MAP NOTE

THE PREPARATION OF THIS MAP IS FOR THE PURPOSE OF
IDENTIFYING THE LOCATION OF THE WATER RIGHT ONLY
AND HAS NO INTENT TO PROVIDE DIMENSIONS OR
LOCATIONS OF PROPERTY OWNERSHIP LINES.

SCALE

1" = 200'

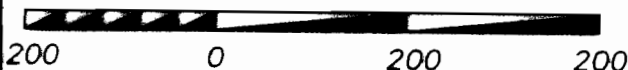


JUNE 13, 2007

WATER RIGHTS



PRIMARY - PERMIT G-11684 T.16S., R.16E., W.M.
TOTAL - 20.0 AC.

MAP 16-16-12C	PLAT	SECTION 12	SECTION 13
TAX LOT	LOT	SE1/4 SW1/4	NE1/4 NW1/4
700	1	2.5 AC.	-
701	2	2.5 AC.	-
702	3	2.5 AC.	-
703	4	2.4 AC.	0.1 AC.
704	5	2.4 AC.	0.1 AC.
705	6	2.5 AC.	-
706	7	2.5 AC.	-
707	8	2.5 AC.	-
TOTAL		19.8 AC.	0.2 AC.

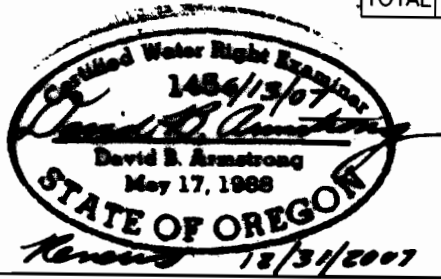

SHEET 1 OF 1
DRG. NO. 07-3591WR.DWG

W.O. 07-3591