


T. 8 S., R. 43 E., W.M.

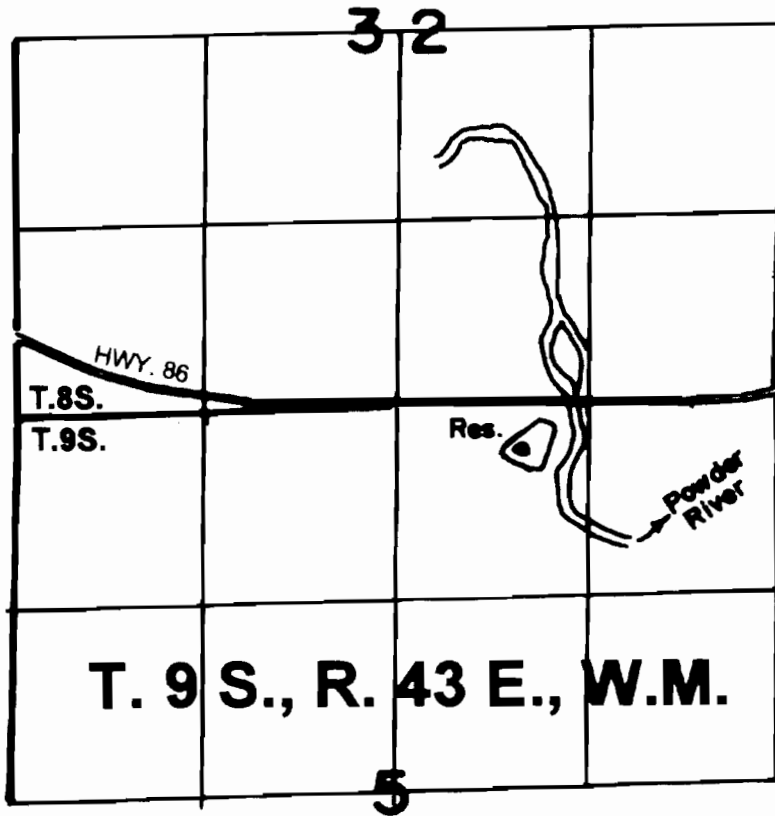

Scale 1" = 1320'

Springs: 250'S @ 1650'W from NE corner Section 5

The purpose of this map is for identifying the location of the water right only and is not intended to provide legal dimensions of property ownership lines.

FINAL PROOF SURVEY

APPL. R-73268 ✓
73269 ✓

PER. R-12052
52841

IN NAME OF

JAMES E. AND DAWNA B. DANIELS

SURVEYED 9-12-2000

RECEIVED

SEP 29 2000

WATER RESOURCES DEPT
SALEM, OREGON

