


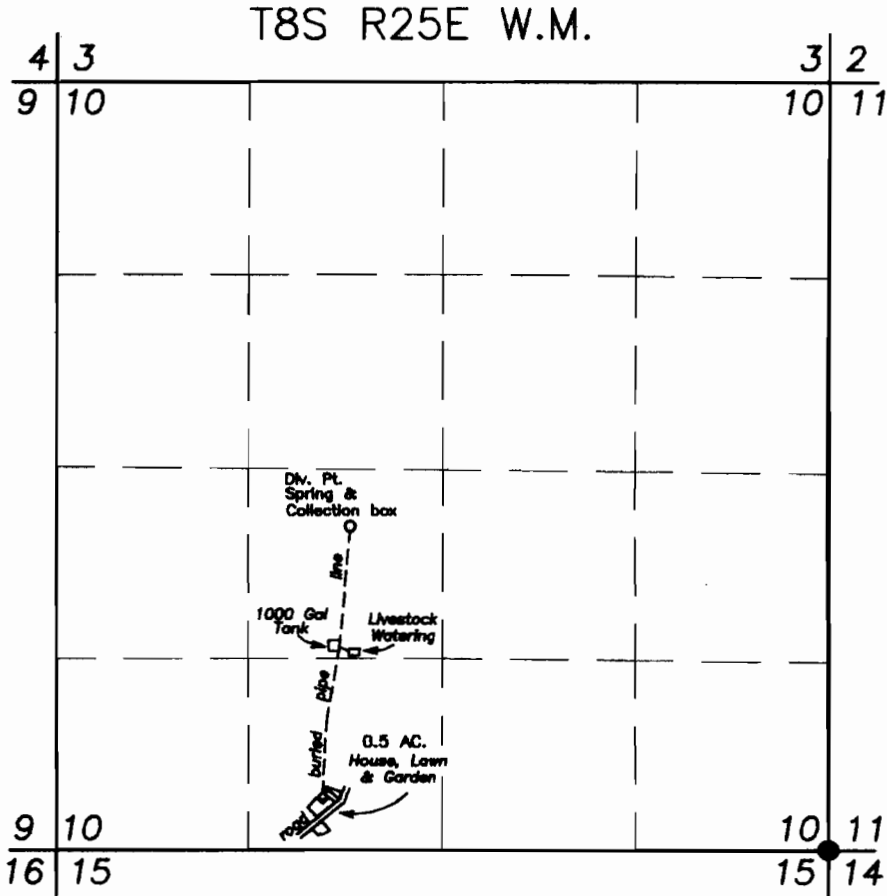

Div. Pt. is 2230' N. and 3270' W. of the SE cor. Sec. 10, T.8S., R.25E.



SCALE 1"=1320'

FINAL PROOF SURVEY

UNDER

PERMIT NO. 52397

REFERENCE FILE NO. S-73600

IN NAME OF

JOSEPH & PATRICIA KINTZ

RECEIVED

SEP 18 2000

WATER RESOURCES DEPT.
SALEM, OREGON

SURVEYED MAY 30, 2000

BY ROBERT D. BAGETT

● FOUND ALUM. MONUMENT

NOTE: The preparation of this map was for the purpose of identifying the location of the proposed water right and has no intent to provide dimensions or location of property ownership lines.

