

BENEFICIAL USE MAP FINAL PROOF SURVEY


Located in portions of the
SE1/4 SW1/4, SW 1/4 SE1/4 Section 20,
NE1/4 NW1/4 of Section 29, Township 27
South, Range 12 West, W.M.
Coos County, Oregon
Application S-72205 & Permit 52232

RECEIVED

APR 16 1998

WATER RESOURCES DEPT.
SALEM, OREGON

Prepared For: Everell D. & Patricia King
James B. & Jereda I. Lynn
Kenneth & Margaret Ludwig
Robert C. & Lulu M. Geaney
Prepared By: Dennis Coude
Surveyed: January 26, 1998

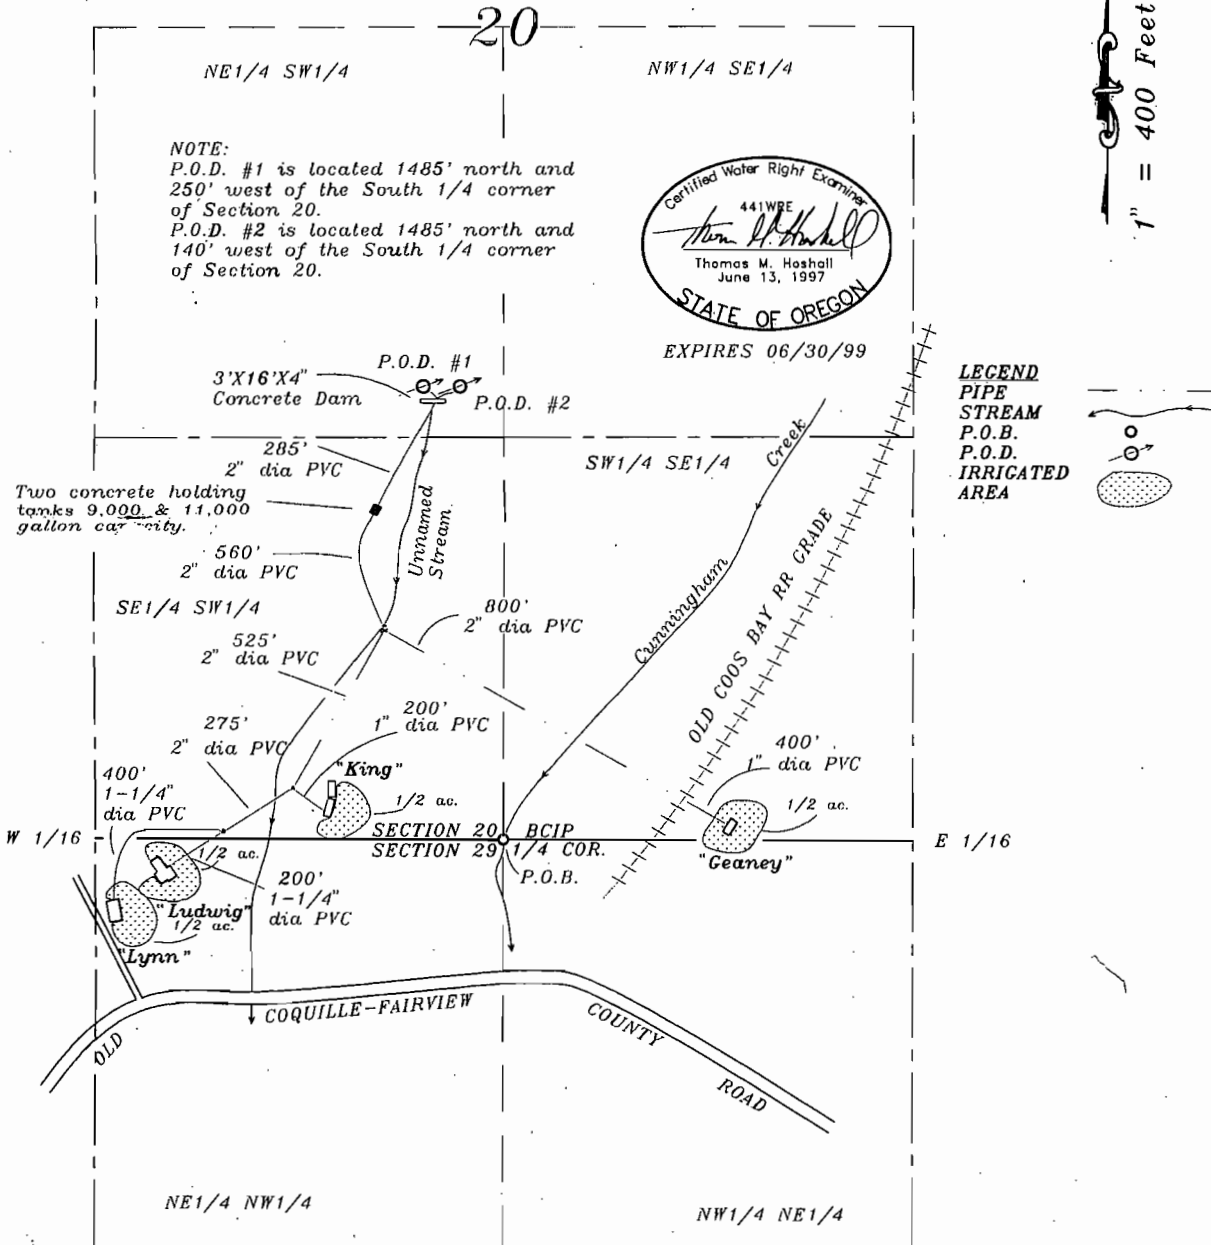

Stuntzner Engineering
& Forestry, LLC

ENGINEERING • LAND SURVEYING • FORESTRY
PLANNING • WATER RIGHTS

705 South 4th St.
Post Office Box 118
Coos Bay, Oregon 97420

Phone (541) 267-2872
Fax (541) 267-0588

EXAMINERS DISCLAIMER STATEMENT

The preparation of this map was for the purpose of
identifying the location of the Water Right only and
has no intent to provide dimensions or location of
property ownership lines.