

RECEIVED


MAR - 4 1997

WATER RESOURCES DEPT.
SALEM, OREGON

SW COR.
DLC 49




SCALE: 1" = 400'

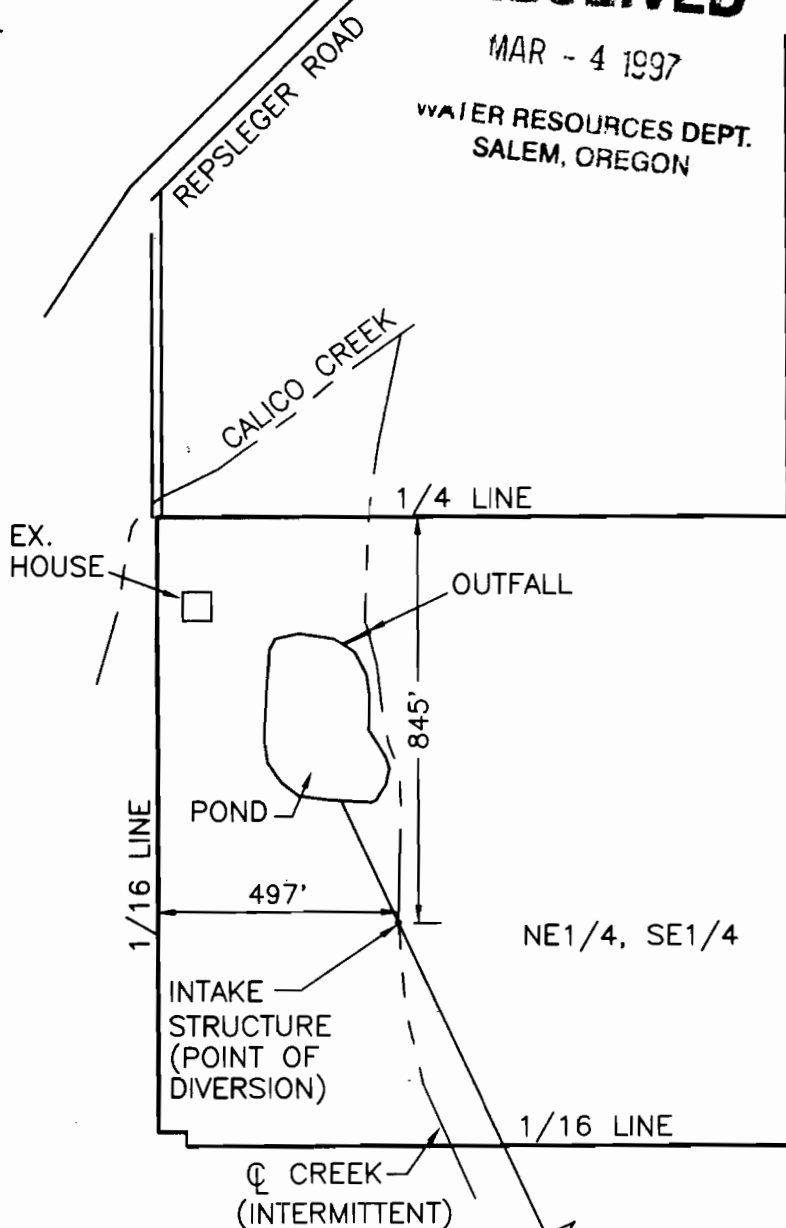

SECTION LINE

THIS MAP IS FOR THE PURPOSE
OF IDENTIFYING THE WATER RIGHT
ONLY AND IS NOT TO PROVIDE
LEGAL DIMENSIONS OR LOCATIONS
OF PROPERTY OWNERSHIP LINES.

THIS MAP WAS PREPARED FROM
A SURVEY PERFORMED BY
ROBERT E. FINDORFF, CWRE

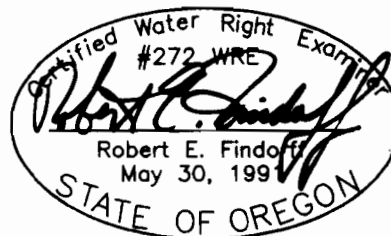

2/24/97

FINAL PROOF SURVEY
UNDER APPLICATION NO. R-74213,
PERMIT NO. R-11526
FOR STEVEN & VERA KILSTON
NE1/4, SE1/4, SEC. 23,
T20S, R4W, W.M.,
LANE COUNTY, OR
T.L. 20-04-23-1500

Geomax
OF OREGON, INC.

ENGINEERING, LAND SURVEYING, BUILDING DESIGN
806 N. NINTH STREET COTTAGE GROVE, OREGON 97424
TELEPHONE- (503) 942-0126 FAX- (503) 942-7935

JOB NO.: 92183	DRAWN: T.F.J.	CHECKED: R.E.F.
DATE: 2/17/97	SHT. 1	OF 1

23 24
26 25