

R5W W.M.

SEP 13 1999


7 8

WATER RESOURCE DEPT
SALEM, OREGON



18 17

Locations of water source
and use from the N.E.
corner of Section 18,
T.4S., R.5W., W.M.-


Spring- South 2,250' West 1760'
Pump Box- South 2,280' West 1,830'
Storage Tank- South 1,950' West 1,470'
House- South 1,840' West 1,800'
Shop & Barn- South 1,950' West 1,850'

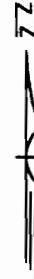

T4S

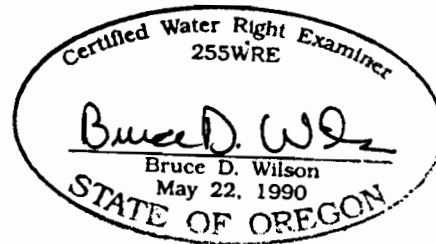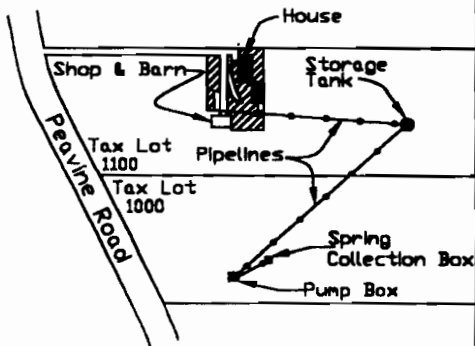

August 14, 1999

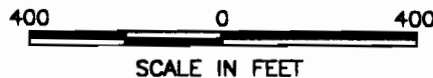

Lawn & Garden Area -

FINAL PROOF SURVEY

UNDER

Application No. S-73254, Permit No. S-51590
in the name of

Douglas E. & Debra A. Aase