


BENEFICIAL USE MAP FINAL PROOF SURVEY

Located in the NW $\frac{1}{4}$ SE $\frac{1}{4}$, SW $\frac{1}{4}$ SE $\frac{1}{4}$ and the SE $\frac{1}{4}$ SE $\frac{1}{4}$
of Section 4, Township 29 South, Range 12 West, W.M.
Coos County, Oregon
Application 72556 Permit 51580

Prepared For: Leila M. Rochek
Prepared By: Dennis Goude
Surveyed: Aug. 11, 1998


1" = 200 Feet
Assessors Scale

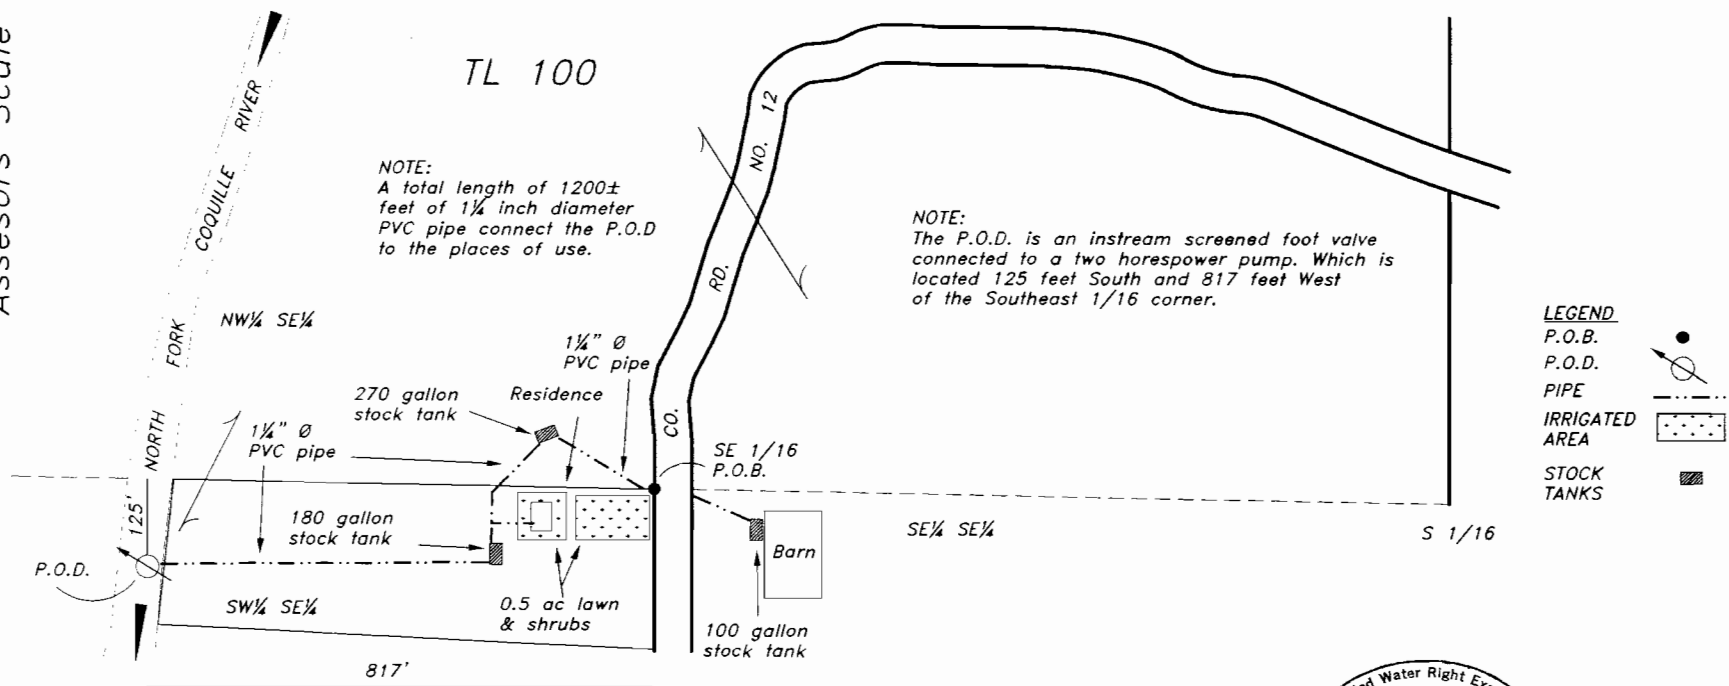

LEGEND
P.O.B. ●
P.O.D. ⦿
PIPE ———
IRRIGATED AREA [dotted box]
STOCK TANKS [hatched box]

EXAMINERS DISCLAIMER STATEMENT

The preparation of this map was for the purpose of identifying the location of the Water Right only and has no intent to provide dimensions or location of property ownership lines.

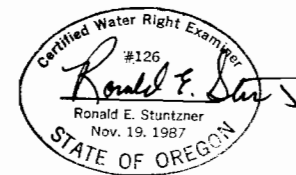

EXPIRES 06/30/00

Stuntzner Engineering
& Forestry, LLC

ENGINEERING • LAND SURVEYING • FORESTRY
PLANNING • WATER RIGHTS

705 South 4th St.
Post Office Box 118
Coos Bay, Oregon 97420
Phone (541) 267-2872
Fax (541) 267-0588