


CLAIM OF BENEFICIAL USE FINAL PROOF MAP

LOCATED IN
THE NORTH EAST 1/4 OF SECTION 8,
TOWNSHIP 41 SOUTH, RANGE 12 WEST, W.M.,
CURRY COUNTY, OREGON

APPLICATION NO. 74051 PERMIT NO. 52011

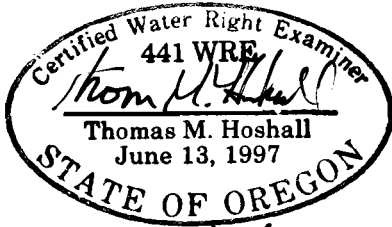

Exp. 6/30/07

LEGEND

POINT OF DIVERSION


● FRUIT TREES

----- 1/2 AC. LAWN & GARDEN, ORCHARD
BDY. LIMITS

----- WATER LINE


EXAMINERS DISCLAIMER STATEMENT

THE PREPARATION OF THIS MAP WAS FOR THE PURPOSE OF IDENTIFYING THE LOCATION OF THE WATER RIGHT ONLY AND HAS NO INTENT TO PROVIDE DIMENSIONS OR LOCATION OF PROPERTY OWNERSHIP LINES.

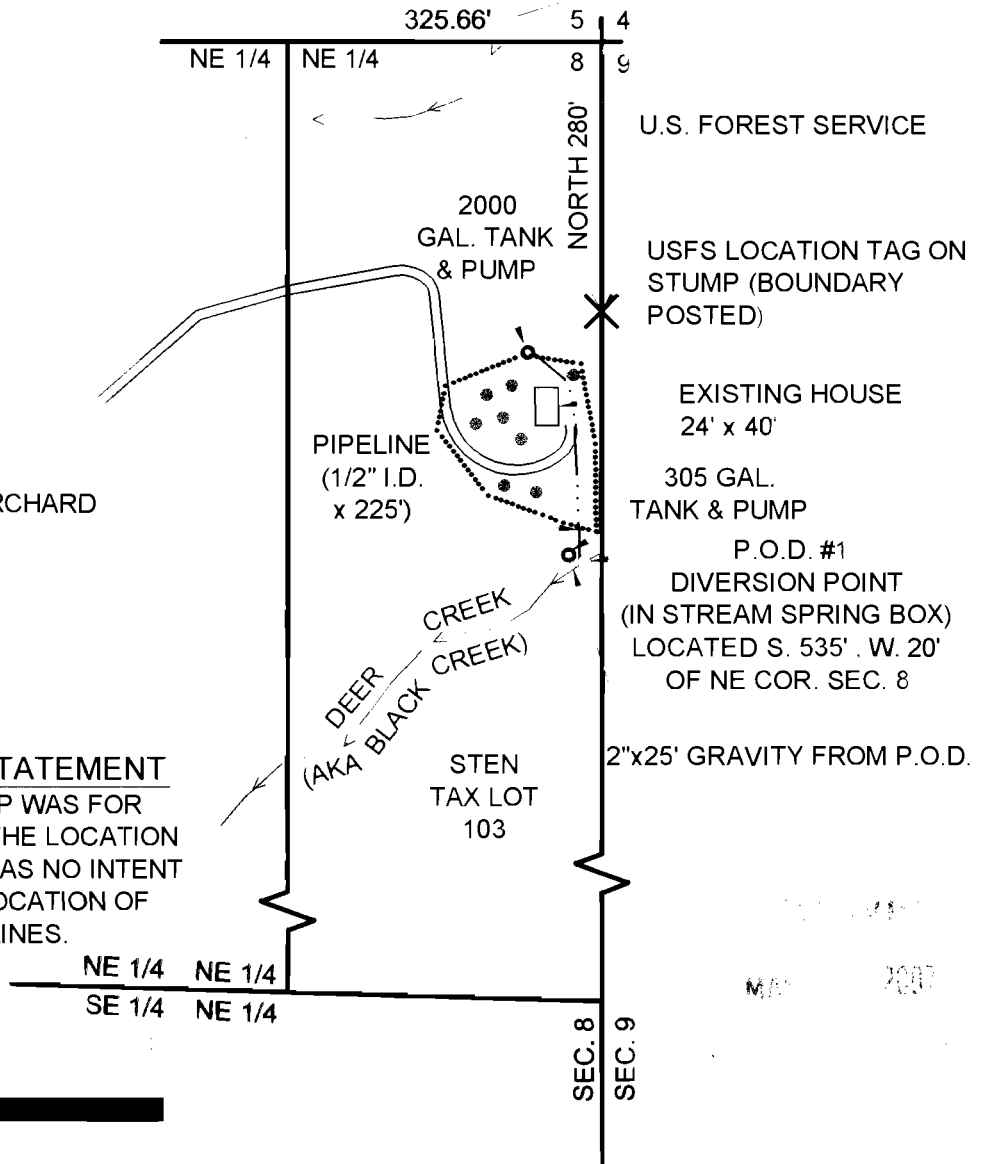

1 inch = 200 feet

ASSESSORS MAP: 41-12-8A TAX LOT 103

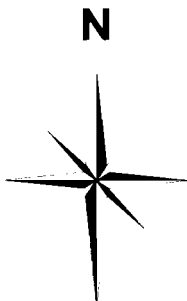

STUNTZNER ENGINEERING & FORESTRY, L.L.C.

ENGINEERING-LAND SURVEYING-FORESTRY-LAND PLANNING-WATER RIGHTS

97829 SHOPPING CENTER AVE.
P.O. BOX 2748 HARBOR,
OREGON 97415

PHONE: (541) 469-5329
FAX: (541) 469-0768
www.stuntzner.com

JOB #: 206-3-085

DATE: 04/25/2007

DRAWN BY: JTC

CHECKED BY: TMH

PREPARED
FOR:

LIN STEN
BROOKINGS, OREGON

SHEET 1 OF 1