


Tax Lot No. TL200 23 12 21DC
Section 21 Township 23 Range 12 W.M.
Coos County

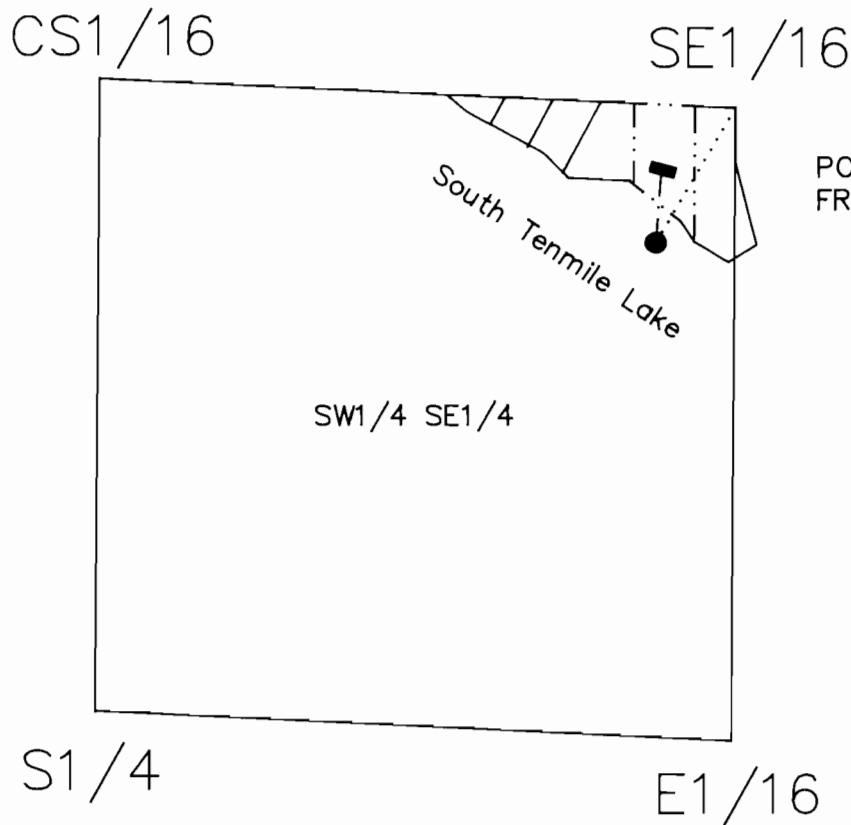

POD BEARS S30°35'W 325'
FROM THE SE1/16 CORNER

Scale 1" = 400'

LEGEND


- HOME
- POINT OF DIVERSION
- WATERLINE
- PROPERTY LINE

EXAMINERS DISCLAIMER STATEMENT

The preparation of this map was for the purpose of identifying the location of the Water Right only and has no intent to provide dimensions or location of property ownership lines.


FINAL PROOF SURVEY
IN THE NAME OF
David and Ronda Amatore

Surveyed on 1/18/04 by H.A. Wilcox

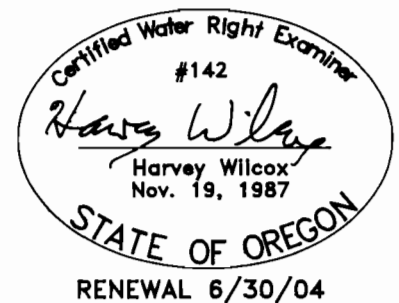

Application No. S-73467
Permit No. 52104

Township 23 South, Range 12 West,
Willamette Meridian

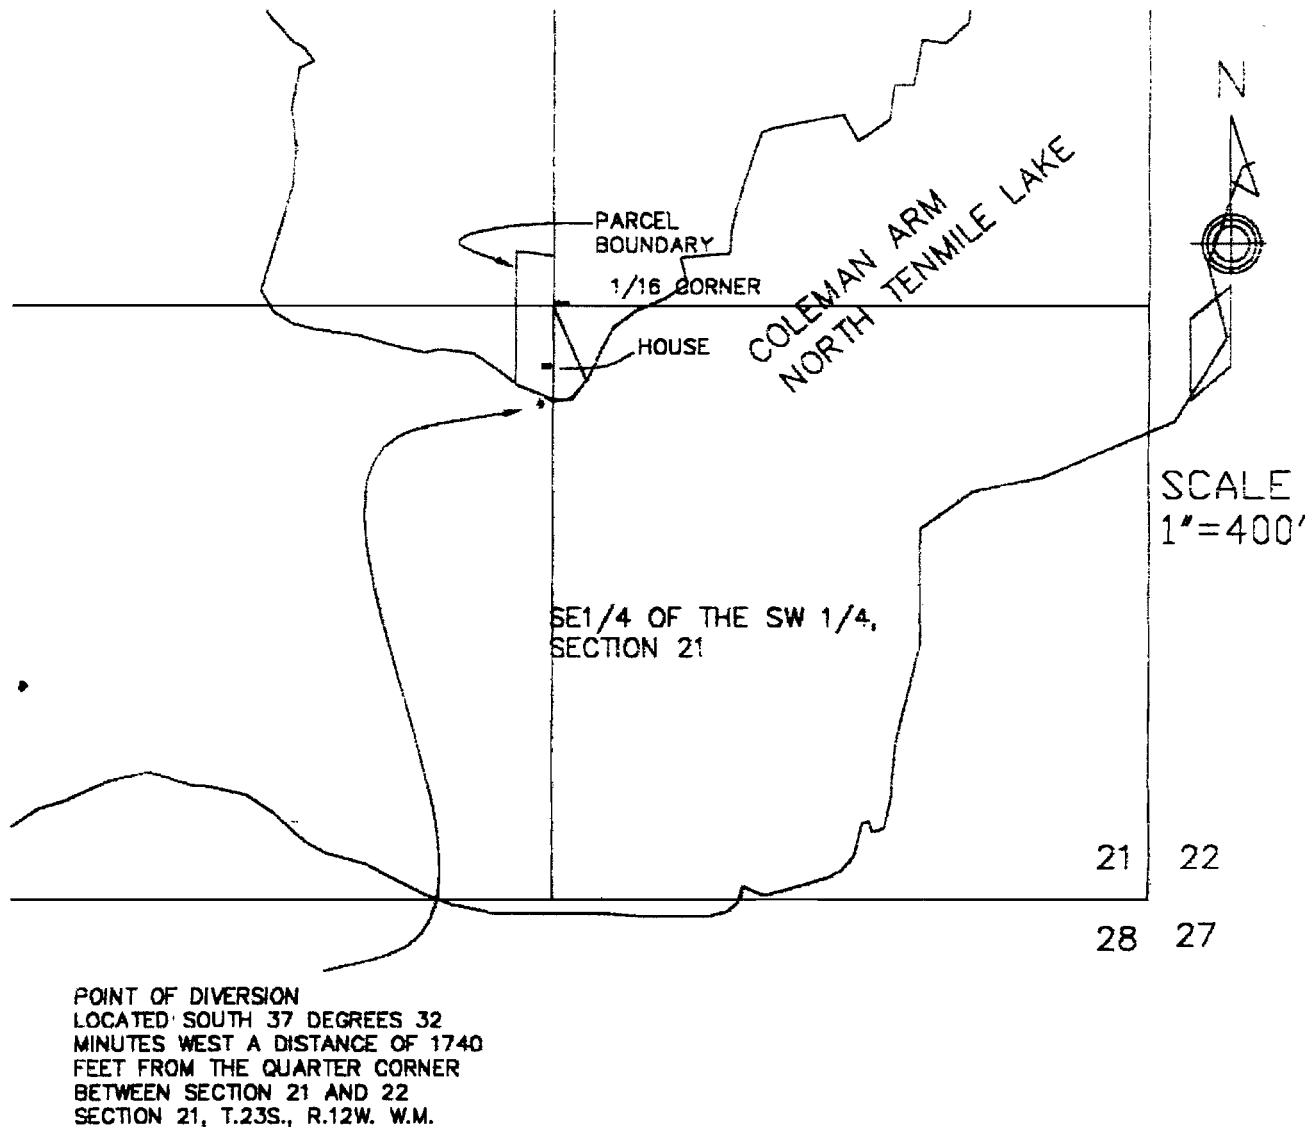


RECEIVED

FINAL PROOF SURVEY

JUN 29 2004

under
Application Number S-73467, Permit Number S-52104
JUNE 10, 2004

WATER RESOURCES DEPT.
SALEM OREGON

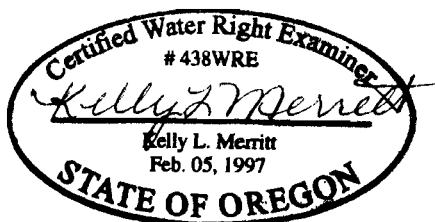

THIS MAP WAS PREPARED FOR THE PURPOSE
OF IDENTIFYING THE LOCATION OF A WATER
RIGHT ONLY AND IS NOT INTENDED TO
PROVIDE LEGAL DIMENSIONS OR LOCATION OF
PROPERTY OWNERSHIP LINES.