


Section 16 Township 24 s Range 12 W W.M.

Located in the E 1/2 of the SE 1/4

Coos County

CS 1/4

SECTION 16 ONLY
P.O.B. E 1/4

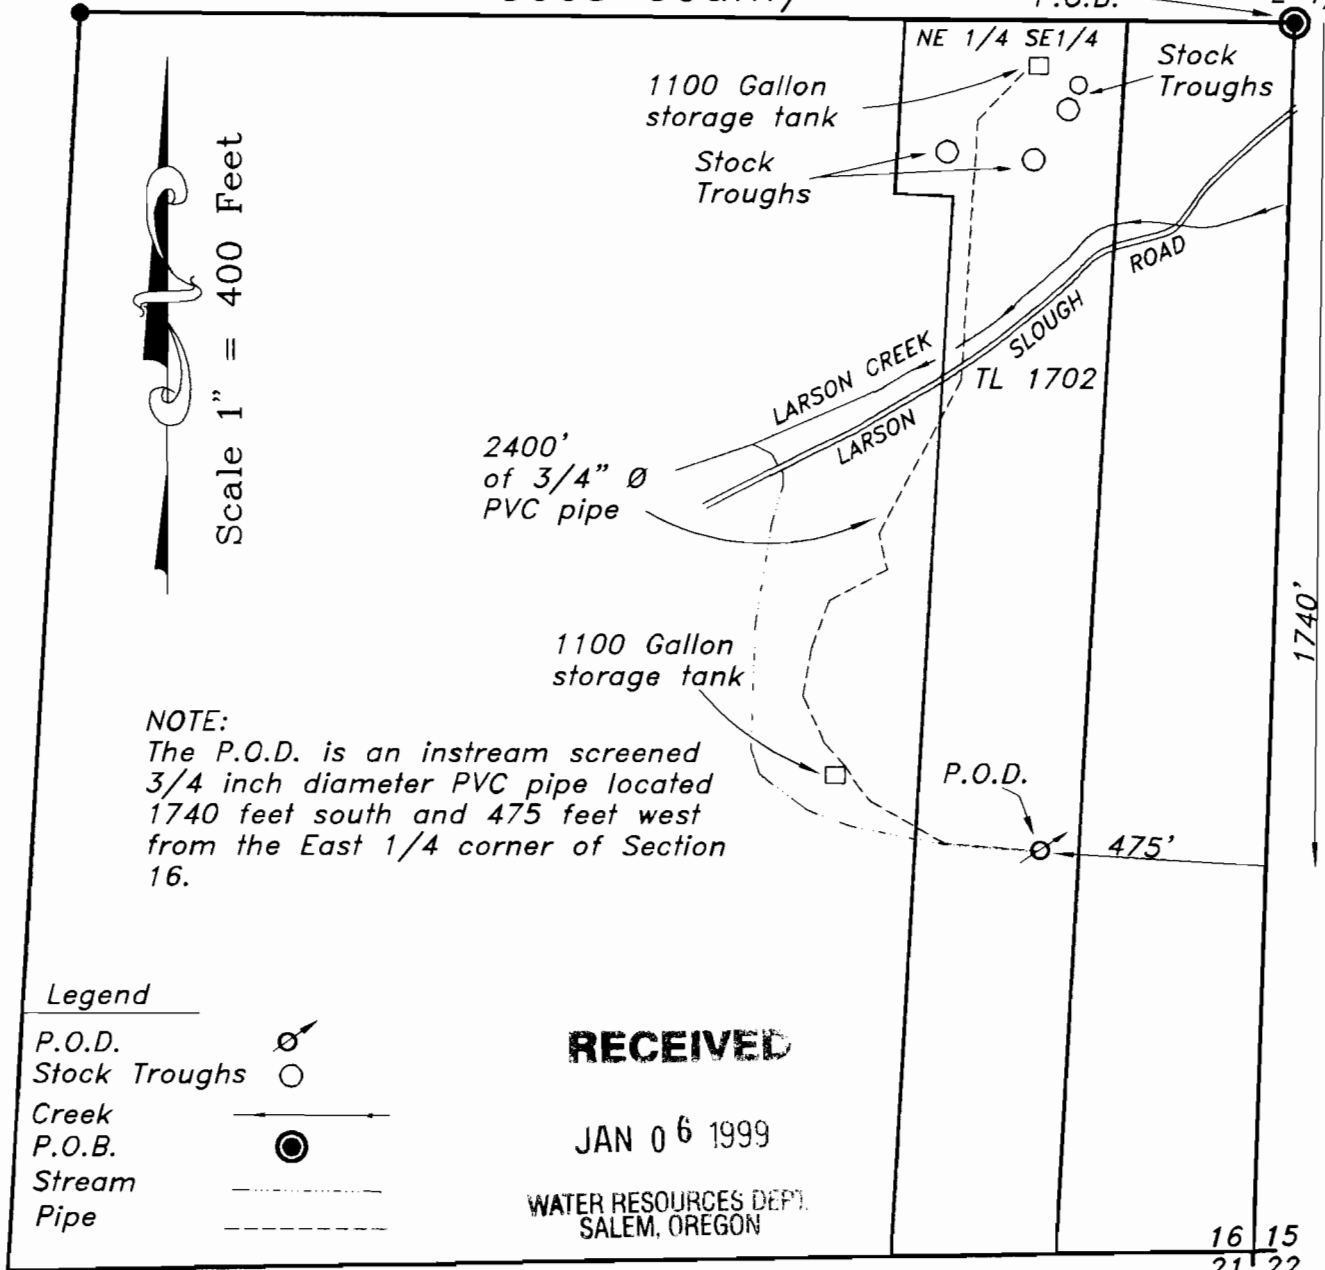

FINAL PROOF SURVEY

Prepared For: John Cheslock
Prepared By: Dennis Goude
Surveyed: December 15, 1998



EXAMINERS DISCLAIMER STATEMENT

The preparation of this map was for the purpose of identifying the location of the Water Right only and has no intent to provide dimensions or location of property ownership lines.

Application No. S-71482

Permit No. 51667