


Tax Lot No. TL1000 & TL1100 23 12 9CA
Section 9 Township 23S Range 12W W.M.
Coos County

RECEIVED

JAN 08 1999

WATER RESOURCES DEPT.
SALEM, OREGON

Scale 1" = 400'

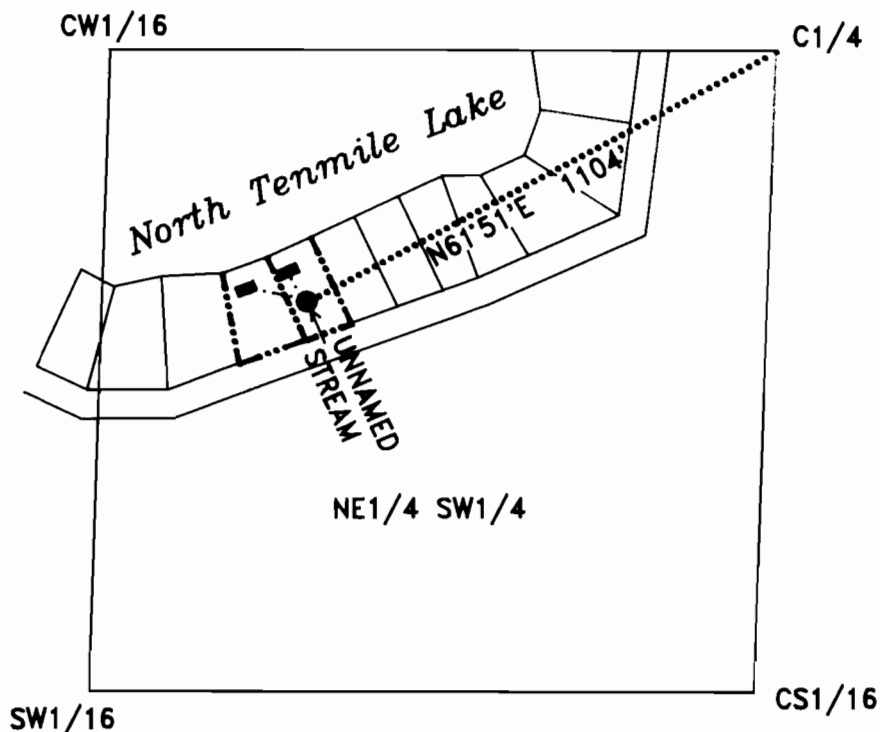

LEGEND

- HOME
- POINT OF DIVERSION
- WATERLINE
- PROPERTY LINE

EXAMINERS DISCLAIMER STATEMENT


The preparation of this map was for the purpose of identifying the location of the Water Right only and has no intent to provide dimensions or location of property ownership lines.

FINAL PROOF SURVEY

IN THE NAME OF

Murray A. Nadeau and Glenn A. Thomas

Surveyed on 9/25/98 by H.A. Wilcox

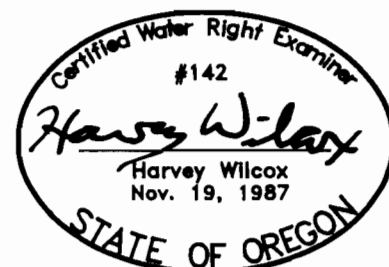

RENEWAL 6/30/00

Application No. S-83447

Permit No. 53394