

T. 5 S., R. 4 W., W.M.

Location: The NE 1/4 of the SE 1/4,
Section 22, T. 5 S., R. 4 W.,
W.M., Yamhill County, Oregon.

DIVERSION
POINT
(SPRING)
N 5057
E 5171

RECEIVED

SEP 09 1998

WATER RESOURCES DEPT.
SALEM, OREGON

I certify that the information I have provided in this final proof is an accurate representation of the permitted water use and is true and correct to the best of my knowledge. This map is to be used for the purpose of identifying the location of water right only and is not intended to provide legal dimensions or locations of property ownership lines.

Matt Dunckel
Matt Dunckel, C.W.R.E.

LEGEND:

- . - . - . = Property line
- — — — = Section line
- — — — = "40" line

PLACE OF USE
(TROUGH)
N 5029
E 5192

POD:
2380' N $\frac{1}{4}$
50' W FROM
SE CORNER,
Section 22

North
Scale: 1"=400'

Amended by WRO
Staff 7-22-08
JWS

C.H. BURCH D.L.C. NO. 72

US LOT 7

US LOT 6

NE. CORNER OF THE
WILLIAM BUFFUM DONATION
LAND CLAIM NO. 48.
N 2374
E 3544


SEC. 22

SEC. 27

SEC. 22

SEC. 23

22

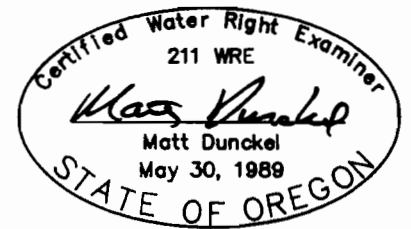

By: Matt Dunckel & Assoc.
19010 Baker Creek Road
McMinnville, OR 97128
Phone: 472-7904

FINAL PROOF SURVEY

UNDER

Application No. S-73850 Permit No. S-51984

IN NAME OF

Lora G. & Arlin R. Homann

Surveyed Sept. 3, 1998