



T 16 S, R 7 W, W.M.

THE PURPOSE OF THIS MAP IS TO IDENTIFY THE LOCATION OF THE WATER RIGHTS. IT IS NOT INTENDED TO PROVIDE INFORMATION RELATIVE TO THE LOCATION OF PROPERTY OWNERSHIP BOUNDARY LINES.

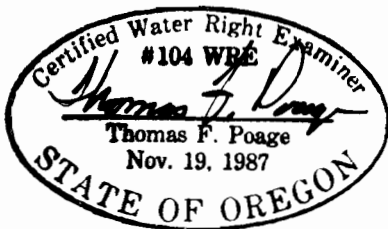

SCALE: 1" = 400'

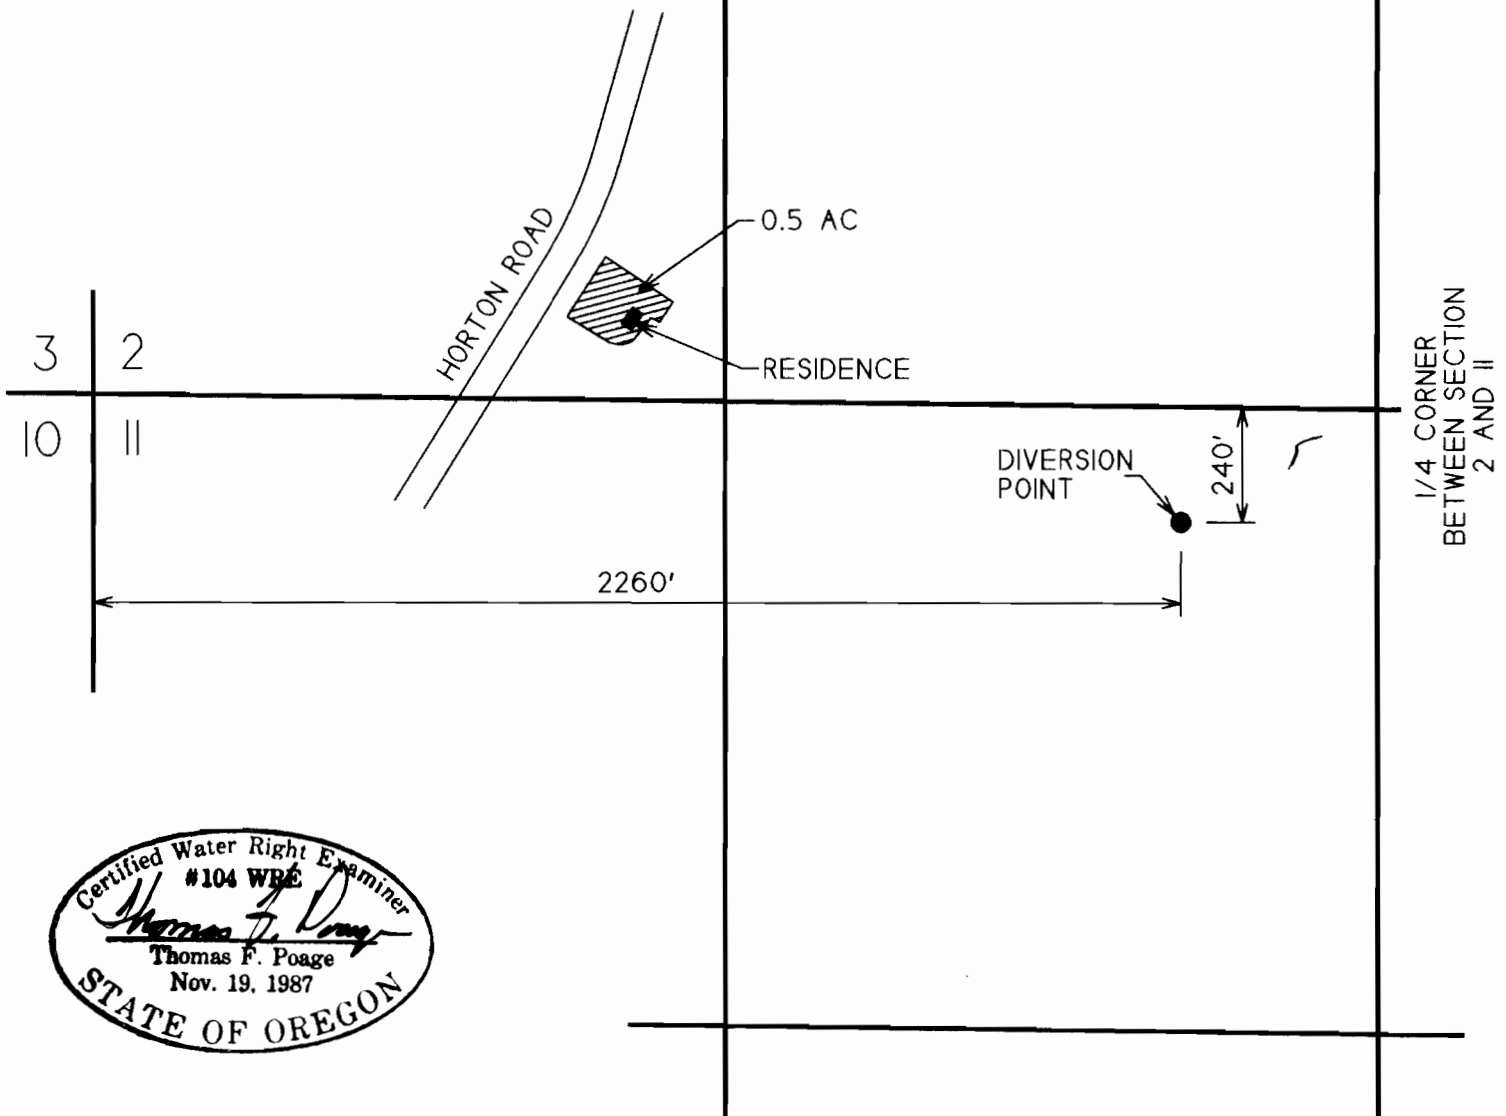

FINAL PROOF SURVEY
UNDER

RECEIVED

APPLICATION NO. S-72335

PERMIT NO. 52092

SEP 18 2000

IN THE NAME OF

WATER RESOURCES DEPT.
STATE OF OREGON

WILLIAM B. BOOTH

CADD FILE: 1789PROF.GCD

COGO FILE: 1789

DRAWN: 10/8/99 DPS
REVISED: 8/22/00 DPS