


SEC. 23, T 28 S, R 12 W WM

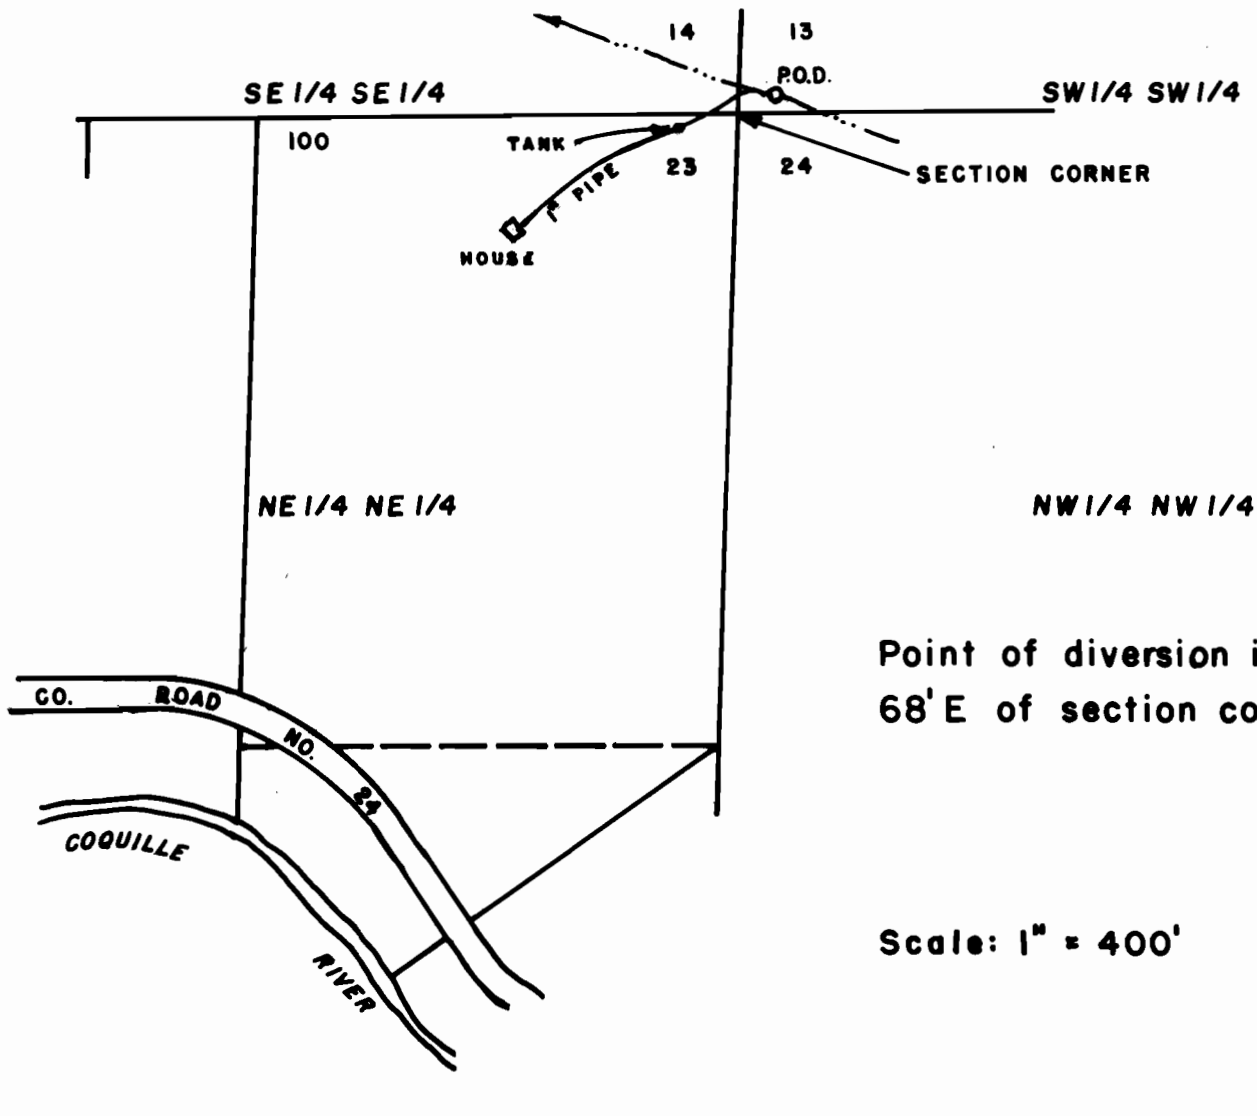

FINAL PROOF SURVEY FOR

RECEIVED


DEC 20 1996

WATER RESOURCES DEPT
SALEM, OREGON

Application No. S-71351 Permit No. 51898

ROGER & LAURA BARRON

Surveyed 7-13 1996 by K. Phelps

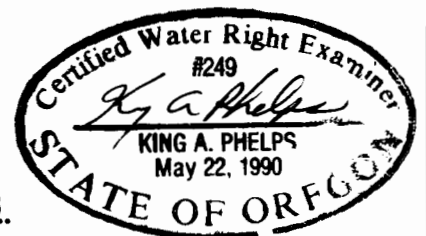

THE PURPOSE OF THIS MAP IS TO IDENTIFY THE LOCATION OF THE WATER RIGHT. IT IS NOT INTENDED TO PROVIDE INFORMATION RELATIVE TO THE LOCATION OF PROPERTY OWNERSHIP BOUNDARY LINES.