


RECEIVED

JUN 16 2003


WATER RESOURCES DEPT.
SALEM, OREGON

THE PREPARATION OF THIS MAP WAS FOR THE
PURPOSE OF IDENTIFYING THE LOCATION OF THE
WATER RIGHT AND HAS NO INTENT TO PROVIDE
DIMENSIONS OR LOCATION OF PROPERTY LINES.

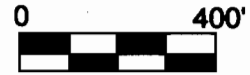

SW1/4, SE1/4

SE1/4, SE1/4

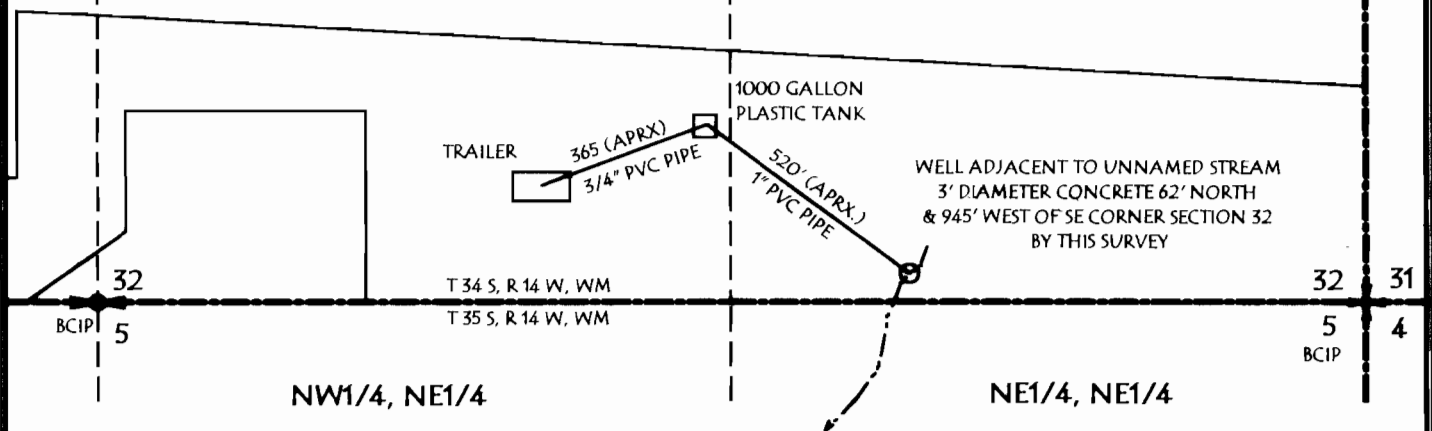


T. 34 S., R. 14 W., W. M.

FINAL PROOF SURVEY

UNDER
APPLICATION #71709 PERMIT #51616

IN THE NAME OF

WILBUR MOORE

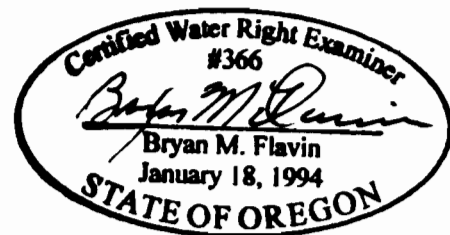

BRYAN FLAVIN LAND SURVEYING
32053 SQUAW VALLEY ROAD
GOLD BEACH, OREGON
97444
541-247-6485

SURVEYD JUNE 6, 2003 BY BRYAN M. FLAVIN