


FINAL PROOF SURVEY MAP
T24S, R4W, WM
SCALE 1" = 1320'

DOUGLAS COUNTY

RECEIVED

IAN 28 2002

WATER RESOURCES DEPT.
SALEM, OREGON

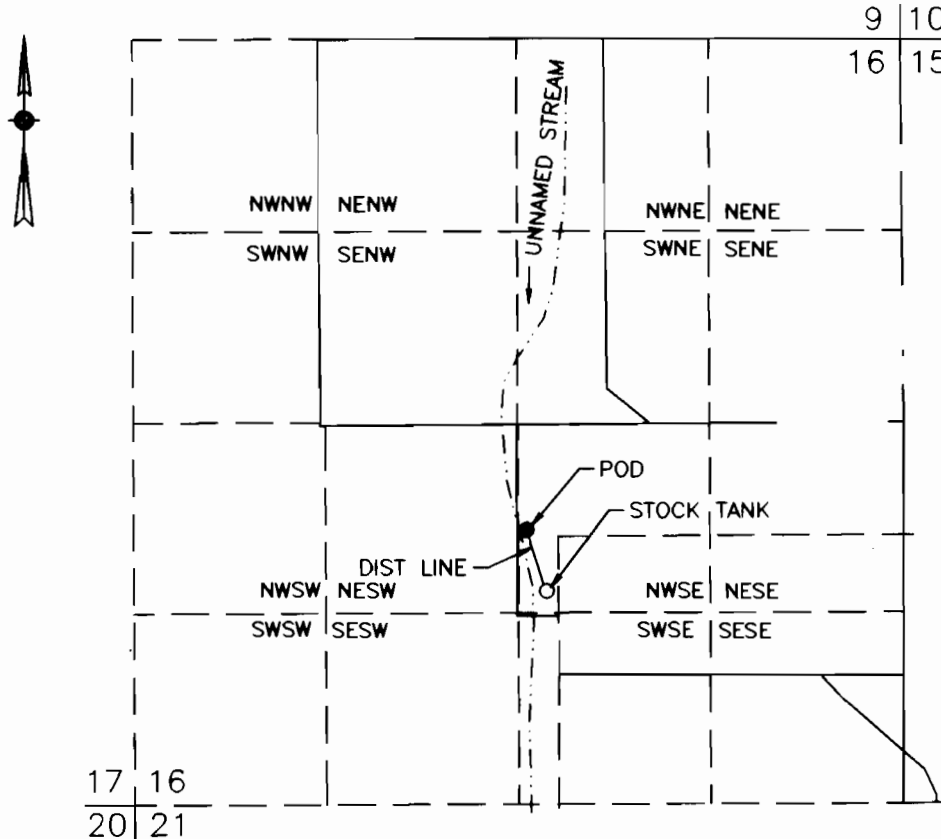

POD IS 1900 FT N AND 2680 FT E FROM SW COR SEC 16

FINAL PROOF SURVEY
UNDER

Application No. S-74266 Permit No. 52799

IN NAME OF

Don & Lisa Melville

Surveyed October 15, 2001 by M E Farr

MAP PREPARED FOR:
DON AND LISA MELVILLE
864 LARKSPUR LANE
OAKLAND, OR 97462

MAP PREPARED BY:
MAURICE E FARR, CWRE
395 NE KIRBY AVENUE
ROSEBURG, OR 97470

THIS IS A LOCATION MAP FOR A FINAL PROOF SURVEY BY DON AND LISA MELVILLE. THIS MAP IS FOR THE PURPOSE OF IDENTIFYING THE LOCATION OF THE WATER RIGHT ONLY AND IS NOT INTENDED TO PROVIDE LEGAL DIMENSIONS OR LOCATIONS OF PROPERTY OWNERSHIP LINES.

