


TOWNSHIP 9 SOUTH, RANGE 2 EAST, W.M.

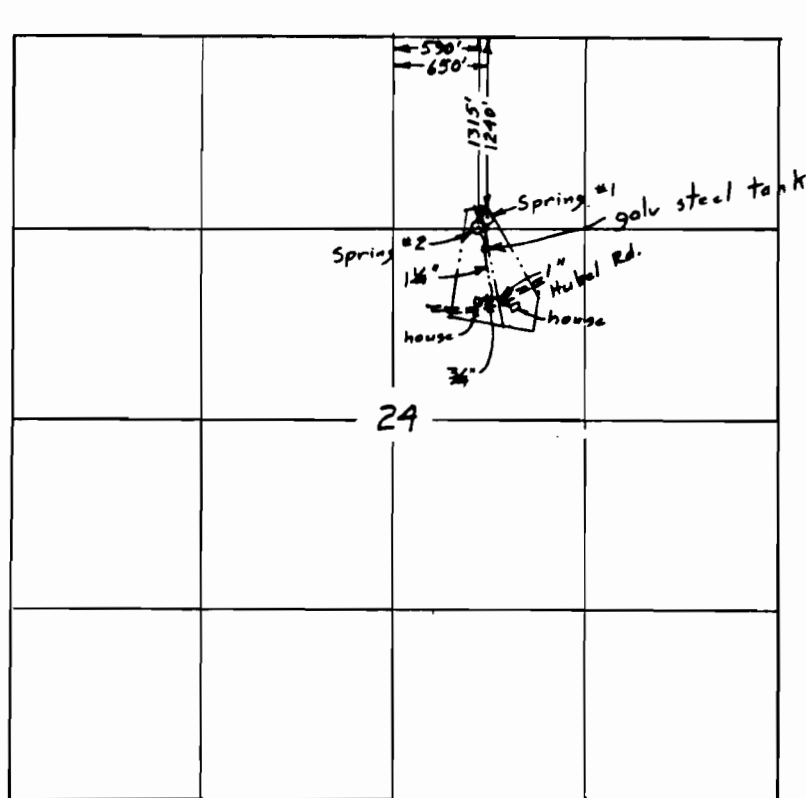


Scale 1" = 1320'

Surveyed Sep 6, 2000

Claim of Beneficial Use Map
for
CARL E. & ELAINE H. BUDLONG

App 77420
Per 52263

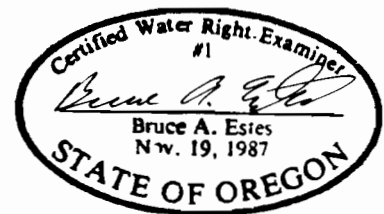

Renewal Dec 31, 2000

This map is for the purpose of
locating a water right only
and has no intent to provide
legal dimensions or the location
of property lines.

ESTES SURVEYS

PO Box 17519 60382 Arnold Rd
Salem, OR 97305-7519 Bend, OR 97702
(503) 585-7593 (541) 382-7391