

RECEIVED

OCT 27 1997

WATER RESOURCES DEP.
SALEM, OREGON

EROSION LINE OF WALLOWA LAKE

TL 212

DRIVEWAY

1/2 HP SUBMERSIBLE
PUMP

1 1/2" PLASTIC
PIPELINE TO HOUSE



1" = 100'

IN THE NE 1/4, SW 1/4, SEC 5,
T3S, R45E.

THIS POINT IS 1250' E & 252' S FROM
THE W 1/4 COR SEC 5, T3S, R45E


POINT OF USE IS APPROX. 1500' E & 290' S
OF WEST 1/4 COR. SEC 5.

POINT OF DIVERSION IS A PUMP SUBMERGED
UNDER THE MINIMUM WATER LEVEL OF WALLOWA
LAKE AND IS 1580' E & 250' S OF W 1/4 COR. SEC. 5,
IN THE NW CORNER OF WALLOWA LAKE.

THIS MAP IS FOR A NON-CONSUMPTIVE DOMESTIC
RIGHT OF 500 GALLONS/DAY (LESS THAN .001
CFS). WATER USED IN THE HOUSE IS COLLECTED
AND DISCHARGED TO THE CITY OF JOSEPH
SEWERAGE SYSTEM WHERE IT IS TREATED
AND DISCHARGED BACK INTO THE WALLOWA RIVER
VIA PRAIRIE CREEK.

MAP IS BASED ON WALLOWA CO.
ASSESSOR MAP 35 45 5BC AND
IS THE ASSESSOR MAP SCALE.

THIS MAP IS PREPARED FOR WATER
RIGHT PURPOSES ONLY AND SHOULD
NOT BE USED FOR PROPERTY
LOCATION PURPOSES.

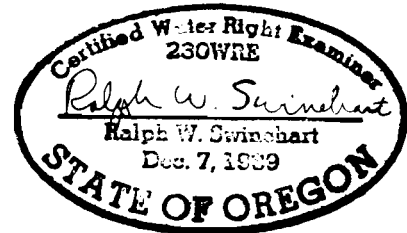

DOMESTIC WATER RIGHT FINAL PROOF MAP

IN SECTION 5, T3S, R45E, WM WALLOWA COUNTY
FOR: GREG AND GAIL JOHNSON

DATE
10/97

JOB

DESIGN
RWS

DRAWN
TCB

WALLOWA MOUNTAIN
ENGINEERING

PO BOX 266
ENTERPRISE, OREGON 97828
426-4085

REVISIONS

SHEET
1 OF
1