
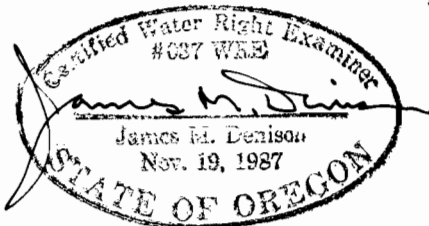


T11S, R11W., W.M.
SECTION 30
LINCOLN COUNTY, OREGON

PT. OF DIVERSION #1 IS
367 FEET NORTH & 263 FEET
WEST OF E 1/4 SEC 30

PT OF DIVERSION #2
IS 461 FEET NORTH &
558 FEET WEST OF
E 1/4 SEC 30

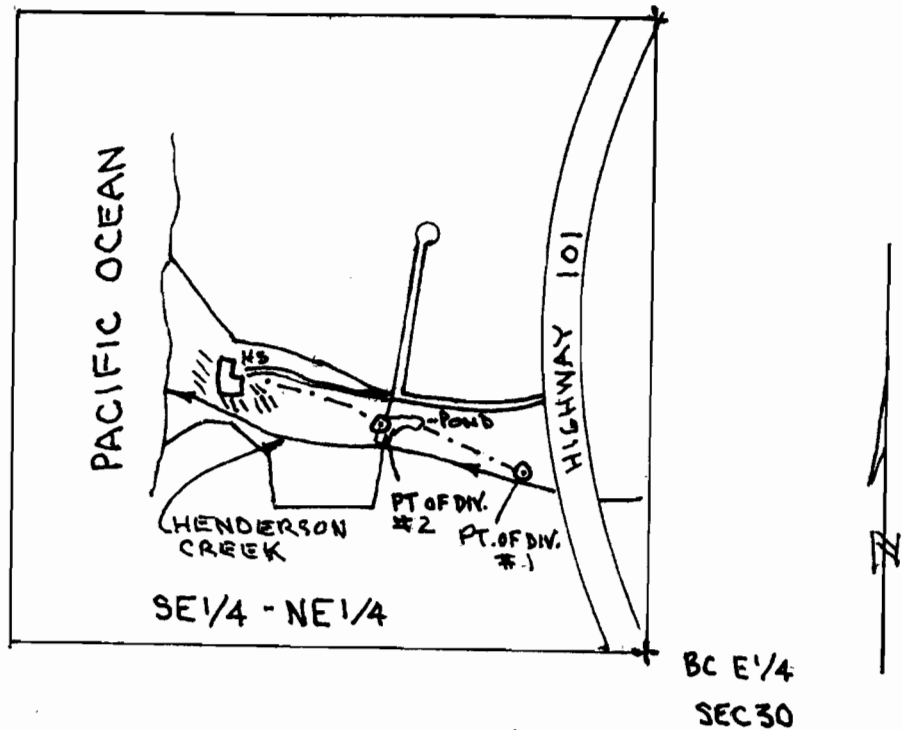

FINAL PROOF SURVEY
UNDER

APPLICATION # S-72651

PERMIT # 52045

IN THE NAME OF

RICHARD H. HILL

SURVEYED: August 7, 2000

BY: James M. Denison

THIS MAP PREPARED SOLEY FOR THE PURPOSE OF SHOWING LOCATION OF A WATER RIGHT, AND IS NOT
INTENDED FOR USE TO PROVIDE DIMENSIONS OR LOCATION OF PROPERTY OWNERSHIP LINES.