


FINAL PROOF SURVEY MAP


T 8 & 9 S R 1 E, W.M.

Frank Timber Resources, Inc. by Dennis Frank
Application G-11275 Permit G-10412

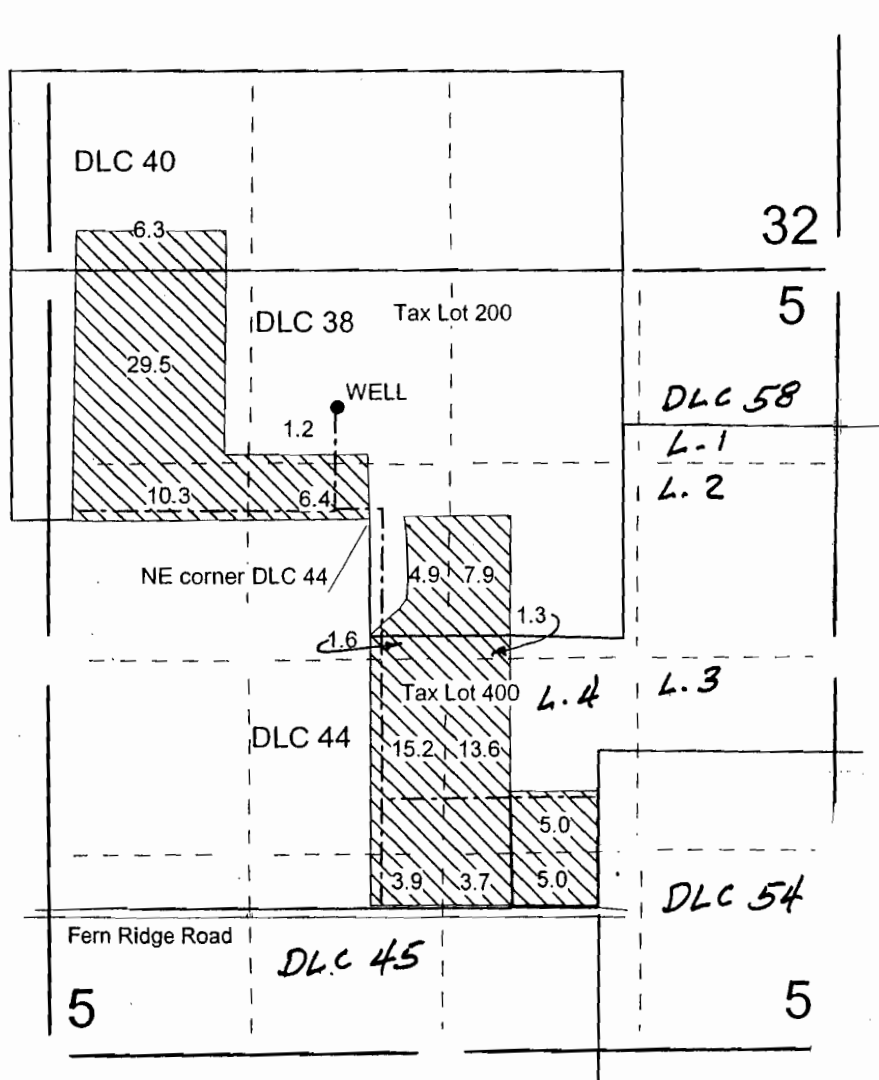


WELL: 780' N & 225' W from the NE corner DLC 44

4" = 1 mile

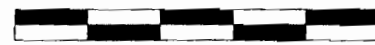

0 2500

This map is not intended to provide legal dimensions or locations of property ownership lines.

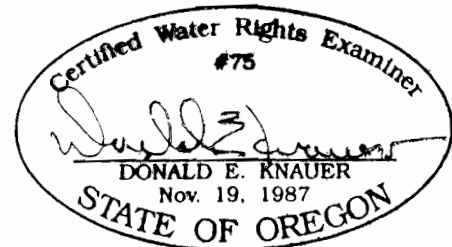

RENEWAL DATE: 6/30/2009

AMENDED 5/8/08 WRD-LHN