
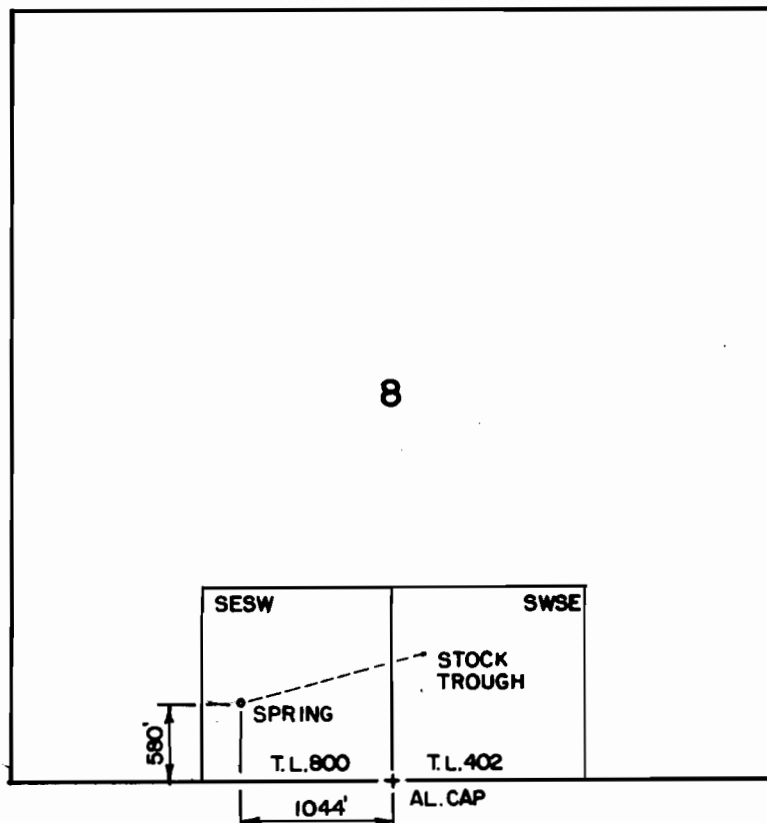


T 16 S, R 30 E, WM

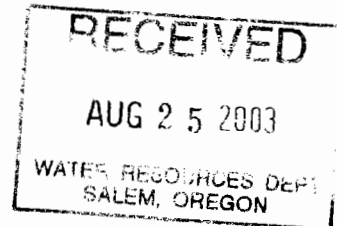

THE PURPOSE OF THIS MAP IS TO IDENTIFY THE LOCATION OF THE WATER RIGHT. IT IS NOT INTENDED TO PROVIDE INFORMATION RELATIVE TO THE LOCATION OF PROPERTY OWNERSHIP.

	FINAL PROOF SURVEY		IN THE NAME OF WILLIAM D. GANDER	
	UNDER APPLICATION S-71902 PERMIT 52578			
	Scale: 4" = 1 MILE	Date: JULY 2003	Job: 1347-03	
	Dsn:	Sht. No.		
Dm: CHRIS	M.A. PALMER & SONS, INC. ENGINEERING & SURVEYING 711 Ponderosa Village • Box 61 Burns, Oregon 97720			
Ckd:	of 1			