


CLAIM OF BENEFICIAL USE  
 FOR: CHARLES W. CARNES &  
 NANJI A. CARNES  
 BY: DUANE KIRBY  
 PERMIT NO. 53474  
 T 30 S, R 3W, W.M.  
 SW1/4 NE1/4  
 SECTION 26  
 TAXLOT 2500

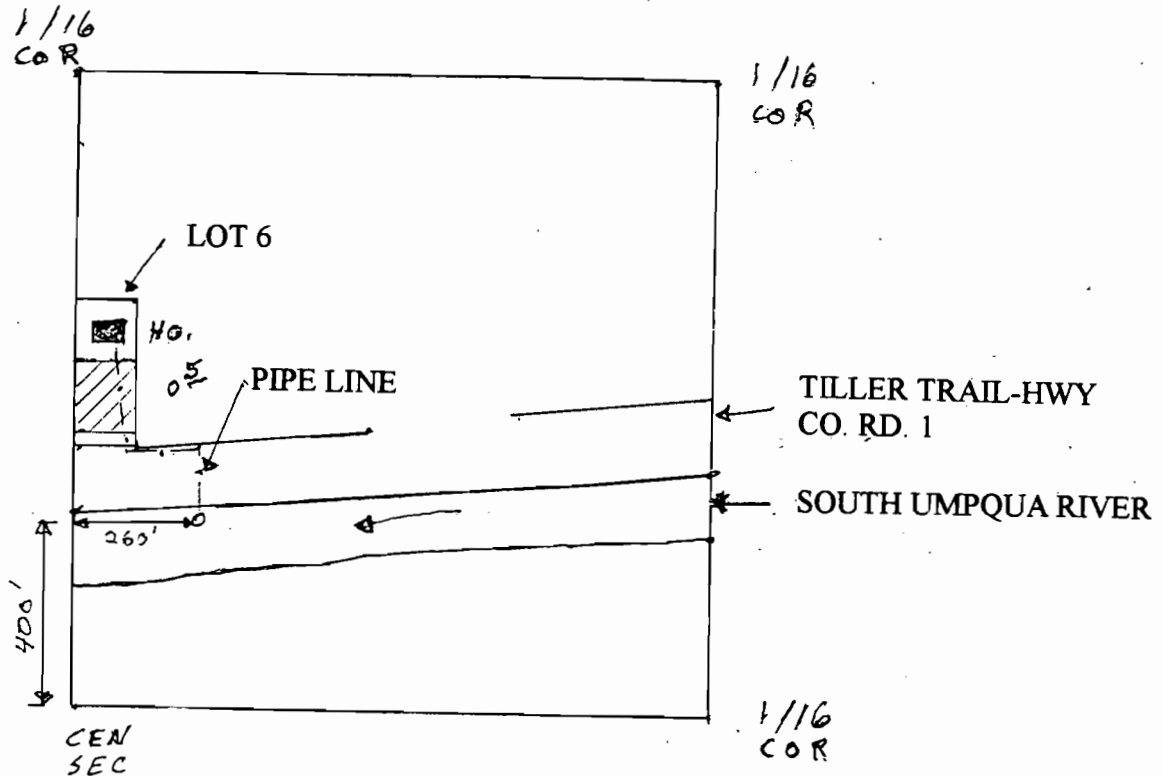

SCALE: 1" = 400'



RECEIVED

JUL 09 2003

WATER RESOURCES DEPT.  
 SALEM, OREGON

THE PURPOSE OF THIS MAP IS TO IDENTIFY THE LOCATION OF THE WATER RIGHT. IT IS NOT INTENDED TO PROVIDE INFORMATION RELATIVE TO THE LOCATION OF PROPERTY OWNERSHIP BOUNDARY LINES.

